IREDELL COUNTY HEALTH DEPARTMENT

Statesville Phone TR 3-7271 Mooresville Phone No. 664-5281

PERMIT TO INSTALL SEPTIC TANK

Permit No. 437 Permit Date 6-1 1973

Owner Bldr. Hope Bros. Builders Inc Address STATESVILLE,

Installed By Hope Bros. Address STATESVILLE -

Location of Property IREDELL HEIGHTS -


DEVON LANE LOT # 60

Tank		Capacity		Length of Lines		Fixtures	
Block	( )	1000	(✓)	225'	( )	No. of Baths	(1½
Precast	(✓)	1250	( )	250'	( )	Dishwasher	( )
		1500	( )	Other 300		Garbage Grdr.	( )
		Other		900 Sq ft.		Other	

NOTIFY HEALTH DEPARTMENT AT LEAST EIGHT HOURS BEFORE TANK IS TO BE INSPECTED.

Final Inspection 6-1 1973 Approved (✓) Disapproved ( )

Remarks IREDELL WATER CORP.

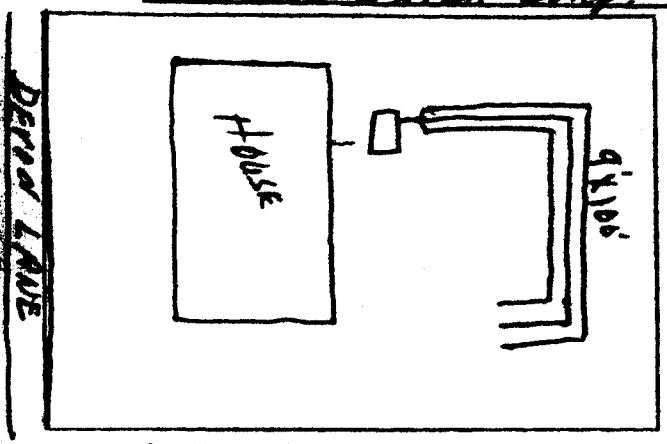

Sketch of Installation

Edward Lee Jr.
Sanitarian