IREDELL COUNTY HEALTH DEPARTMENT

Statesville Phone TR 3-7271 Mooresville Phone No. 664-5281

PERMIT TO INSTALL SEPTIC TANK

Permit No. Budi Permit Date 5-18 1973

Owner J.D Kitching Address PO Box 562 Statesville, N.C.

Installed By Herman Gibson Address Statesville, N.C

Location of Property Iredell Heights


Devon Dr.

Tank		Capacity		Length of Lines		Fixtures	
Block	( )	1000	(✓)	225'	( )	No. of Baths	(1½
Precast	(✓)	1250	( )	250'	( )	Dishwasher	(✓)
		1500	( )	Other 240		Garbage Grdr.	( )
		Other				Other	

NOTIFY HEALTH DEPARTMENT AT LEAST EIGHT HOURS BEFORE TANK IS TO BE INSPECTED.

Final Inspection 5-18 1973 Approved (✓) Disapproved ( )

Remarks Iredell Water Corp.

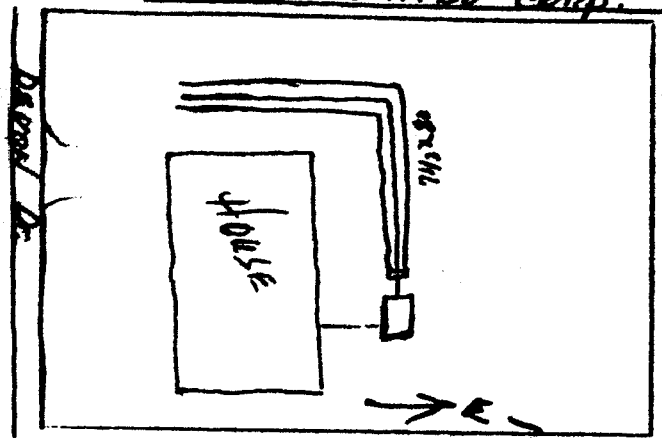

Sketch of Installation

Sanitarian