IREDELL COUNTY HEALTH DEPARTMENT

STATESVILLE 704-878-5305 MOORESVILLE 704-664-5281

IMPROVEMENT PERMIT / AUTHORIZATION TO CONSTRUCT / OPERATION PERMIT / EXISTING SYSTEM INSPECTION

PERMIT# 150387 PIN# 4746260479 DATE 6-10-08

OWNER OR APPLICANT Craig Gentry PHONE: Business 704 902 1537 Home 704 881-0176

ADDRESS 120 Postell Dr.

LOCATION Hwy 21 N to Shumaker, (L) on Nixon, (L) on Postell

SUBDIVISION Shadowlwood BLOCK / SECTION ____ LOT 19 LOT AREA .552 SITE CLASS. PS DESIGN FLOW 360 L.T.A.R. .3

Septic Tank: 1000 Gallons: STB 1012 Date 2-11-08

Pump Tank: ____ Gallons: PT ____ Date ____

Pump Make: ____ Model ____ Serial No. ____

Nitrification Field: No Fields 1 Square Feet 1200 Linear Feet 300

No Lines 3 Trench Width 36 Max Trench Bottom Depth 36 Gravel Depth ____

☐ New System ☐ Repair ☐ Expansion System Type: I II III IV V VI

System Description: 25% Reduction Grav.

Repair System Description: 25% Reduction Grav.

Maintenance Agreement Required: ☐ Yes ■ No

■ House/Mod. Home ☐ Mobile Home ☐ Business ☐ Other

No. Bedrooms 3 No. Persons ____ No. Employees ____


Water Supply: ☐ Individual ■ Public ☐ Community

■ Gravity ☐ Pressure ☐ Slab ■ Crawl Space ☐ Basement w/plumbing ☐ Basement wo/plumbing


Comments:/Conditions:

Comments:/Conditions: POLYLOK Filter + marker

INITIAL SITE SKETCH

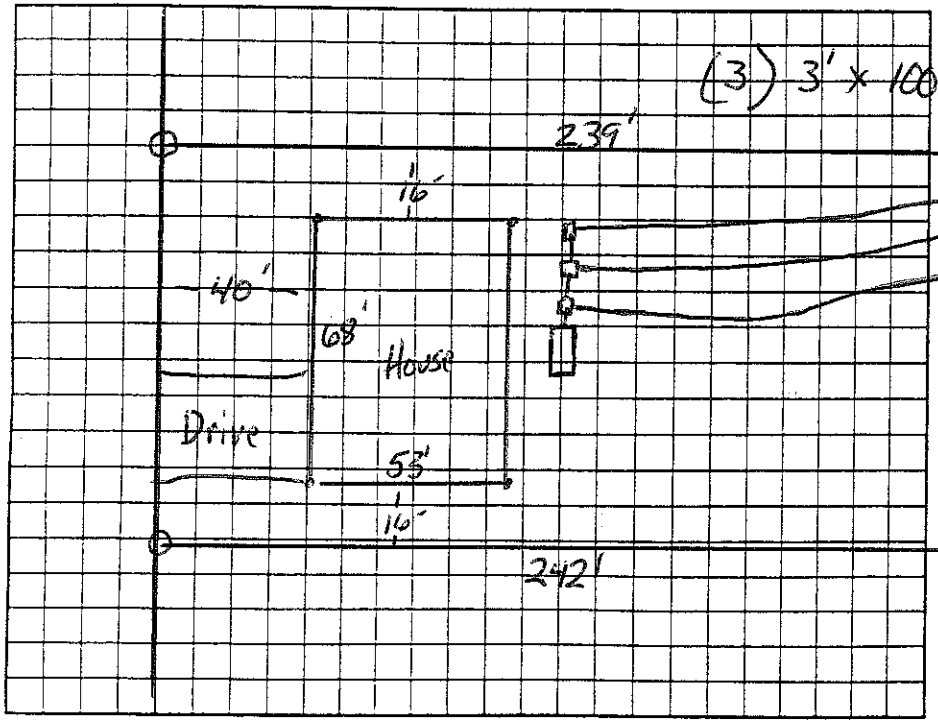

AS BUILT SKETCH

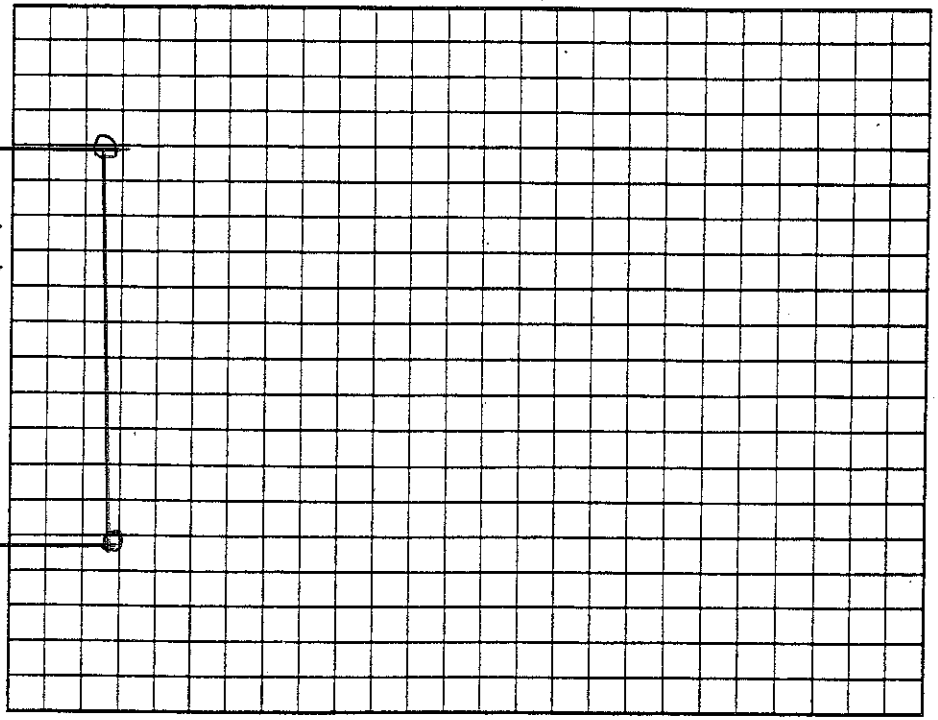

Permit can be suspended or revoked if any false information is supplied toward securing the permit/any unauthorized changes are made to the site/any unauthorized changes are made in the installation of the system. Improvement Permit with plat valid without expiration ☐ Improvement Permit with site plan valid for sixty months ■ Authorization to Construct is valid for a period equal to that of Improvement Permit – not to exceed sixty months.

Signed: Craig Gentry date 6-27-08 Installed by: Craig Thompson Landings

Improvement Permit by: [signature] date 6-10-08 Operation Permit by: [signature] date 1-14-09

Authorization to Construct by: [signature] date 6-10-08 Existing System Inspection by: ____ date ____

HEALTH DEPT. COPY: WHITE OWNER COPY (FINAL): YELLOW OWNER COPY (INITIAL): PINK