IREDELL COUNTY HEALTH DEPARTMENT

CI

STATESVILLE 704-878-5305 MOORESVILLE 704-664-5281

IMPROVEMENT PERMIT / AUTHORIZATION TO CONSTRUCT / OPERATION PERMIT / EXISTING SYSTEM INSPECTION

PERMIT# 145584 PIN# 4746260491 DATE 11-5-07

OWNER OR APPLICANT Tom Palmer Homes PHONE: Business 980-241-9693 Home

ADDRESS P.O. Box 337, Davidson NC 28036

LOCATION 21 North (L) Shoreline (L) Niven (L) Postell Lot # 8 on Rt

SUBDIVISION Shaven Wood BLOCK / SECTION LOT 18 LOT AREA .547 SITE CLASS. PS DESIGN FLOW 360 L.T.A.R. .8

Septic Tank: 1000 Gallons: STB 872 Date 1-12-08

Pump Tank: Gallons: PT Date

Pump Make: Model Serial No.

Nitrification Field: No Fields 1 Square Feet 600=1200' Linear Feet 300'

No Lines 3x100' Trench Width 36" Max Trench Bottom Depth 36" Gravel Depth N/A ☒ Gravity ☐ Pressure

☒ New System ☐ Repair ☐ Expansion System Type: I II III IV V VI

System Description: Graveless 25% Reduction

Repair System Description: 10 50' Rows Lt Fill

Maintenance Agreement Required: ☐ Yes ☒ No

☒ House/Mod. Home ☐ Mobile Home ☐ Business ☐ Other


No. Bedrooms 3 No. Persons 6 No. Employees

Water Supply: ☐ Individual ☒ Public ☐ Community

☐ Slab ☒ Crawl Space ☐ Basement w/plumbing ☐ Basement wo/plumbing

Comments:/Conditions: (1) Contours Shot in & Fitfield By USFW6 Lowest Pts, Tu Humps & Bumps, Graded & Smooth as Uniformly (2) Keep Stubout high enough for gravity fall to tank & 1st Line & Backfill Depression between

INITIAL SITE SKETCH

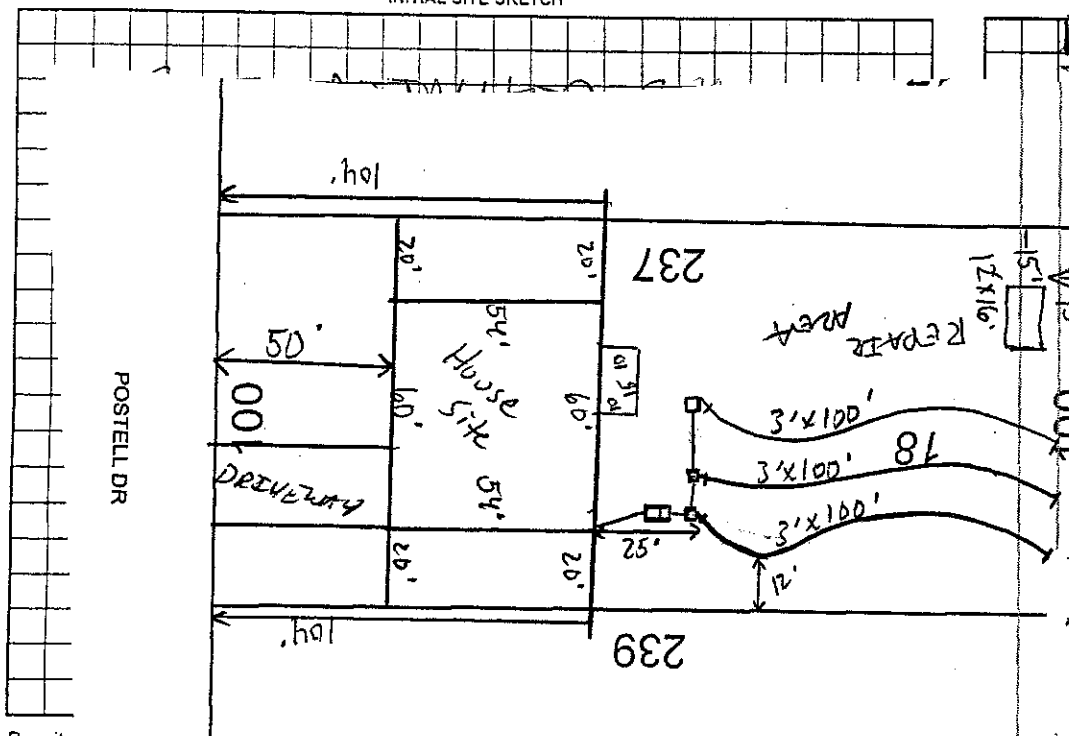

Comments:/Conditions: septic lines & back of home. If not permit will be void. (3) Explained situation will build Excessive grading will also void permit (4) NO FILL TO MTN. DEPOSITS IN SOILS, RAKE SIDEWALLS DOWN & INSTALL AT TOP

AS BUILT SKETCH

Permit # 145584

Pin # 4746260491

1 inch equals 50 feet

The proposed Building addition does not appear to impact the existing septic system.

**NOTE:

R.S.

Date: 8-24-09

ICHD-Environmental Health Division

Permit c

Permit with plat valid without expiration ☐ Improvement Permit with site plan valid for sixty months ☒

Authorization to Construct is valid for a period equal to that of Improvement Permit – not to exceed sixty months.

Signed: date

Improvement Permit by: date 11-5-07

Authorization to Construct by: date 11-5-07

Installed by: Leonard McSwain

Operation Permit by: date 3-28-08

Existing System Inspection by: date

HEALTH DEPT. COPY: WHITE OWNER COPY (FINAL): YELLOW OWNER COPY (INITIAL): PINK