IREDELL COUNTY HEALTH DEPARTMENT

STATESVILLE 704-878-5305 MOORESVILLE 704-664-5281

IMPROVEMENT PERMIT / AUTHORIZATION TO CONSTRUCT / OPERATION PERMIT / EXISTING SYSTEM INSPECTION

PERMIT # 153576 PIN # 4746-26-1209 DATE 12-4-08

OWNER or APPLICANT RANDY WILSON PHONE: Business (704) 880-8219 Home:

OWNER or APPLICANT ADDRESS 120 WHITE DOGWOOD LN, STATESVILLE, NC 28625

LOCATION / DIRECTIONS S CHIPLEY FORD, R NIXON, L POSTELL, LOT ON RIGHT (17)

SUBDIVISION SHADOW WOOD BLOCK / SECTION LOT # 17 LOT AREA .542 ACRES DESIGN FLOW 360 GPD L.T.A.R. .3

Septic Tank 1000 Gallons: STB 1000/2 Date 5-508

Pump Tank Gallons: P T Date

Pump Make Model Serial #

Nitrification Field No Fields 1 No Lines 5 Linear Feet 300

Trench Width 36" Max. Trench Bottom Depth 36" Gravel Depth N/A

☑ New System ☐ Repair ☐ Expansion System Type I II (III) IV V VI

System Description: 25% RED GRAVITY

Repair System Description: 50% GRAVITY, 50% PUMP

Maintenance Agreement Required ☐ YES ☑ NO

☑ GRAVITY ☐ PRESSURE


☑ Residence No. Bedrooms 3 ☐ Business No. Persons ☐ Other No. Employees ☐ Slab ☑ Crawl Space ☐ Basement w/plumbing ☐ Basement w/o plumbing

Water Supply: ☐ Private ☑ Public ☐ Community


Comments / Conditions: MAINTAIN 100' FROM PUBLIC WATER WELL, MAINTAIN FALL TO TANK & LINES W/O EXCEEDING 36" TRENCH BOTTOM. MAINTAIN ≥15' FROM WATER DIVERSION, GRADE UNIFORMLY ON CONTOUR. ALL SETBACKS SHALL BE MAINTAINED

Comments / Conditions

INITIAL SITE SKETCH

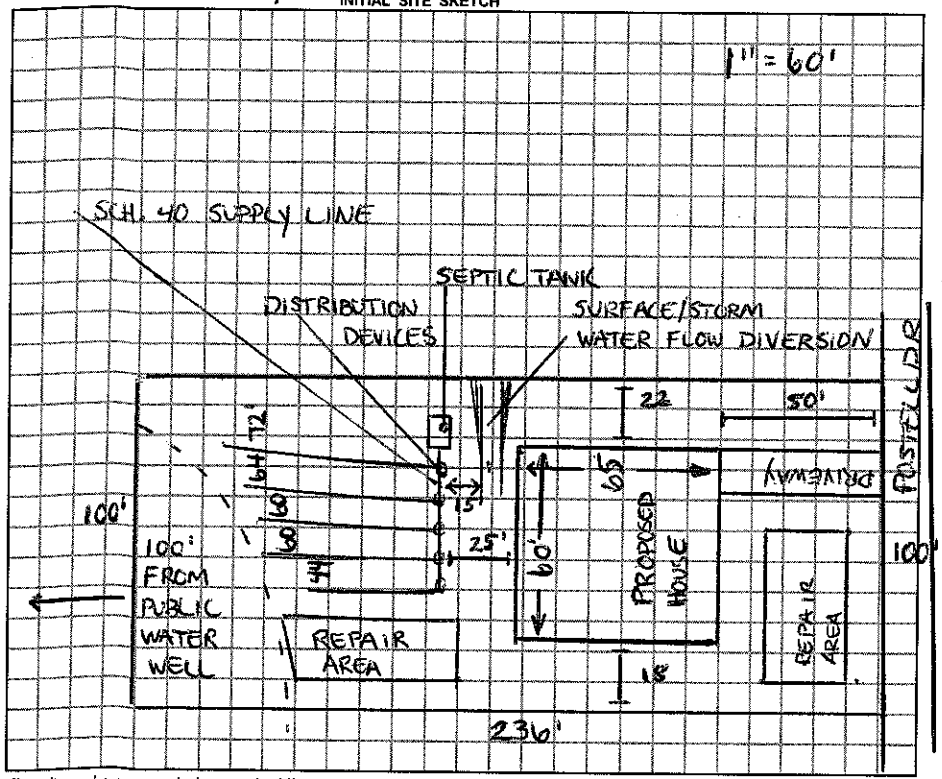

AS BUILT SKETCH

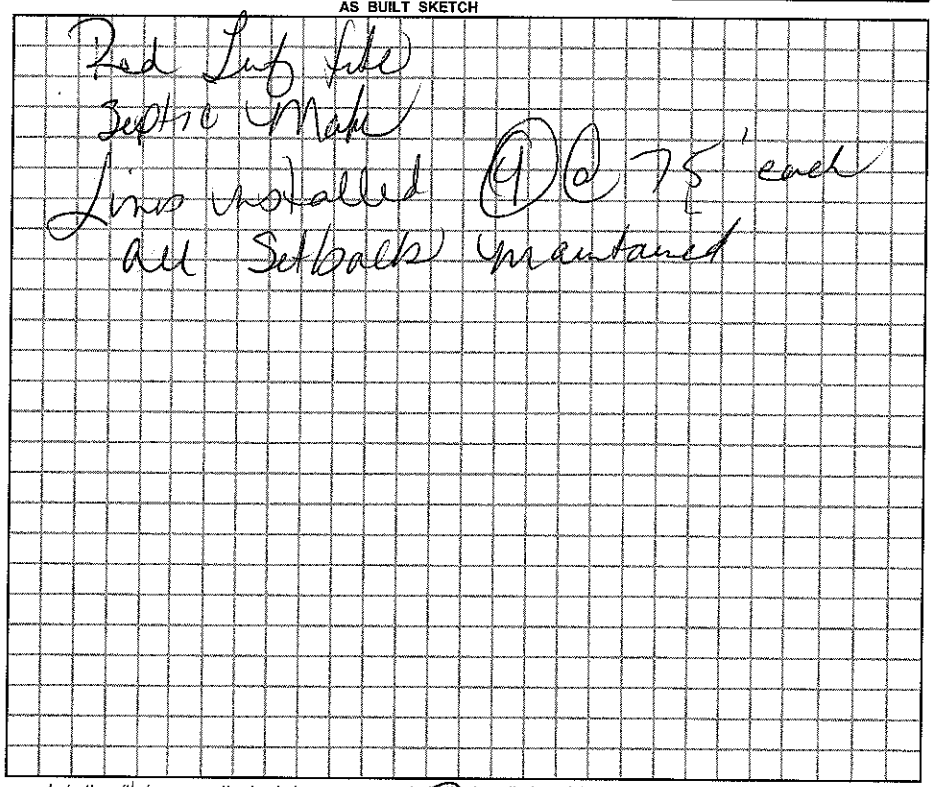

Permit can be suspended or revoked if any false information is supplied toward securing the permit / any unauthorized changes are made to the site / any unauthorized changes are made in the installation of the system.

☐ IMPROVEMENT PERMIT w / plat valid without expiration. ☑ IMPROVEMENT PERMIT w / site plan valid for 60 mos. ☑ AUTHORIZATION TO CONSTRUCT valid for period equal to IMPROVEMENT PERMIT-not to exceed 60 mo.

Owner / Applicant Signature: Randy Wilson Date 12-5-08

Improvement Permit by: Kyle Baker Date 12-4-08

Authorzation to Construct by: Kyle Baker Date 12-4-08

YOU SHOULD CONTACT A LOCATOR SERVICE PRIOR TO ANY EXCAVATION.

Installed by: Steve Graham

Operation Permit by: [signature] Date: 11-3-09

Existing System Inspected by: Date:

WHITE COPY Environmental Health YELLOW COPY (Final) Owner / Applicant PINK COPY (Initial) Owner / Applicant