# IREDELL COUNTY HEALTH DEPARTMENT

STATESVILLE 704-878-5305 MOORESVILLE 704-664-5281

## IMPROVEMENT PERMIT / AUTHORIZATION TO CONSTRUCT / OPERATION PERMIT / EXISTING SYSTEM INSPECTION

PERMIT# 141218 PIN# 4746263085 DATE 4-26-07

OWNER OR APPLICANT Wilson Building PHONE: Business 704 880 3219 Home 704 881 0071

ADDRESS Postell Dr.

LOCATION 21N to Shumaker (L), (L) on Nixon, (L) on Shadow Wood

SUBDIVISION Shadow Wood BLOCK / SECTION ____ LOT 5 LOT AREA .528 SITE CLASS PS DESIGN FLOW 360 L.T.A.R. .3

Septic Tank: 1000 Gallons; STB 1012 Date 9-5-01
Pump Tank: ____ Gallons; PT ____ Date ____
Pump Make: ____ Model ____ Serial No. ____
Nitrification Field: No Fields 1 Square Feet 1200 Linear Feet 300
No Lines 4 Trench Width 36" Max Trench Bottom Depth 36" Gravel Depth ____

☒ New System ☐ Repair ☐ Expansion System Type: I II III IV V VI
System Description: 25% Reduction Gravity
Repair System Description: 50% Reduction Pump
Maintenance Agreement Required: ☐ Yes ☒ No

☒ House/Mod. Home No. Bedrooms 3
☐ Mobile Home No. Persons ____
☐ Business No. Employees ____
☐ Other ____


Water Supply: ☐ Individual ☒ Public ☐ Community

☒ Gravity ☐ Pressure ☐ Slab ☒ Crawl Space ☐ Basement w/plumbing ☐ Basement wo/plumbing


Comments:/Conditions:

Comments:/Conditions:
Jillian Septic Tite
Septic maker

INITIAL SITE SKETCH

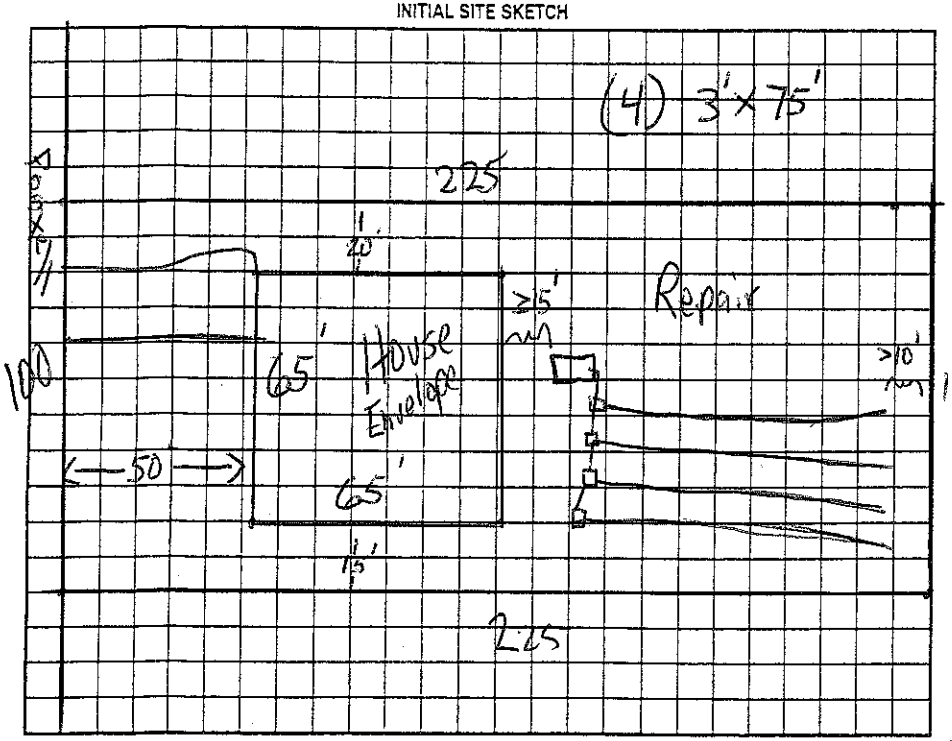


AS BUILT SKETCH

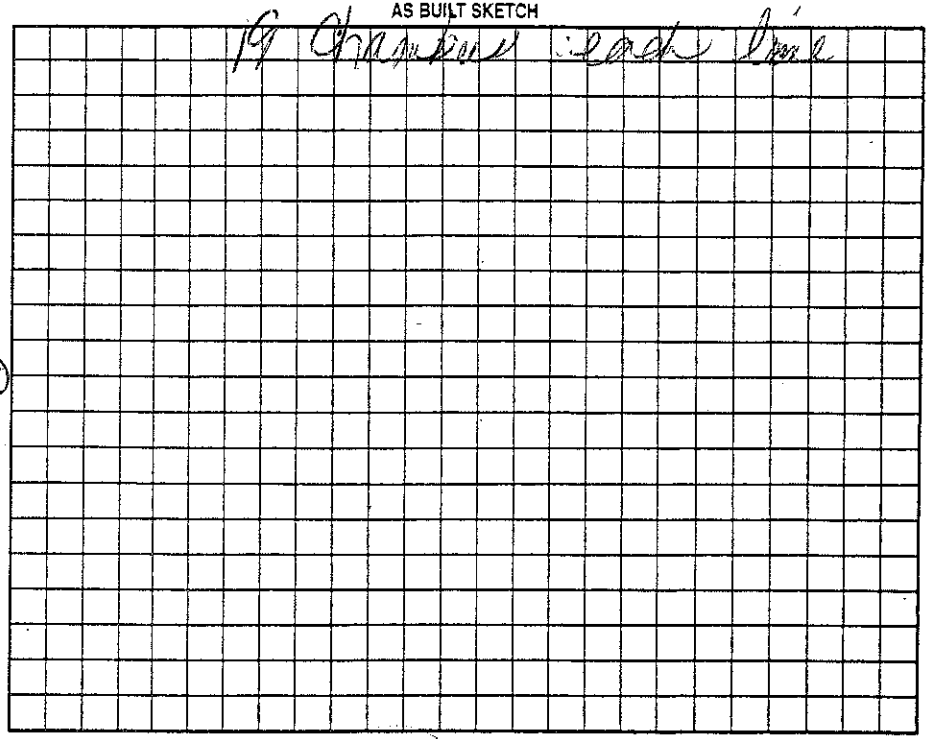


Permit can be suspended or revoked if any false information is supplied toward securing the permit/any unauthorized changes are made to the site/any unauthorized changes are made in the installation of the system. Improvement Permit with plat valid without expiration ☐ Improvement Permit with site plan valid for sixty months ☒ Authorization to Construct is valid for a period equal to that of Improvement Permit – not to exceed sixty months.

Signed: ____ date 5-8-07 Installed by: ____

Improvement Permit by: ____ date 4-26-07 Operation Permit by: ____ date 5-21-07

Authorization to Construct by: ____ date 4-26-07 Existing System Inspection by: ____ date ____

HEALTH DEPT. COPY: WHITE OWNER COPY (FINAL): YELLOW OWNER COPY (INITIAL): PINK