CI

IREDELL COUNTY HEALTH DEPARTMENT

STATESVILLE 704-878-5305 MOORESVILLE 704-664-5281

IMPROVEMENT PERMIT / AUTHORIZATION TO CONSTRUCT / OPERATION PERMIT / EXISTING SYSTEM INSPECTION

PERMIT# 139175 PIN# 4746263375 DATE 12/19/06

OWNER OR APPLICANT Lee Heats Builders PHONE: Business 704 539 4862 Home

ADDRESS Postell Dr.

LOCATION 115N (R) on Chipley Ford, (R) Nixon (R) Postell, Property on left

SUBDIVISION Shadow Wood BLOCK / SECTION LOT 2 LOT AREA 1.518 SITE CLASS. PS DESIGN FLOW 360 L.T.A.R. .3

Septic Tank: 1000 Gallons: STB 760 Date 2-26-07

Pump Tank: Gallons: PT Date

Pump Make: Model Serial No.

Nitrification Field: No Fields 1 Square Feet 1200 Linear Feet 300

No Lines 4 Trench Width 36" Max Trench Bottom Depth 36"

☒ New System ☐ Repair ☐ Expansion System Type: I (II) III IV V VI

System Description: 25% Reduction

Repair System Description: 50% Reduction (pump)

Maintenance Agreement Required: ☐ Yes ☒ No

☒ House/Mod. Home No. Bedrooms 3

☐ Mobile Home No. Persons

☐ Business No. Employees

☐ Other


Water Supply: ☒ Individual ☐ Public ☐ Community

Gravel Depth n/a ☒ Gravity ☐ Pressure ☐ Slab ☒ Crawl Space ☐ Basement w/plumbing ☐ Basement wo/plumbing


Comments/Conditions:

Comments/Conditions:
Red Filter

INITIAL SITE SKETCH

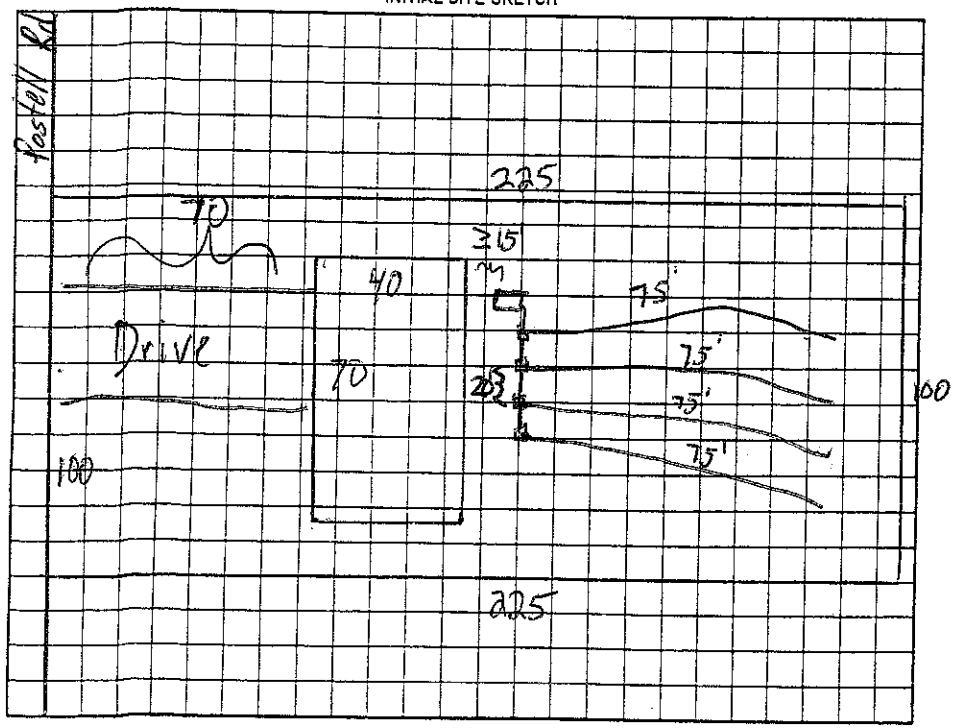

AS BUILT SKETCH

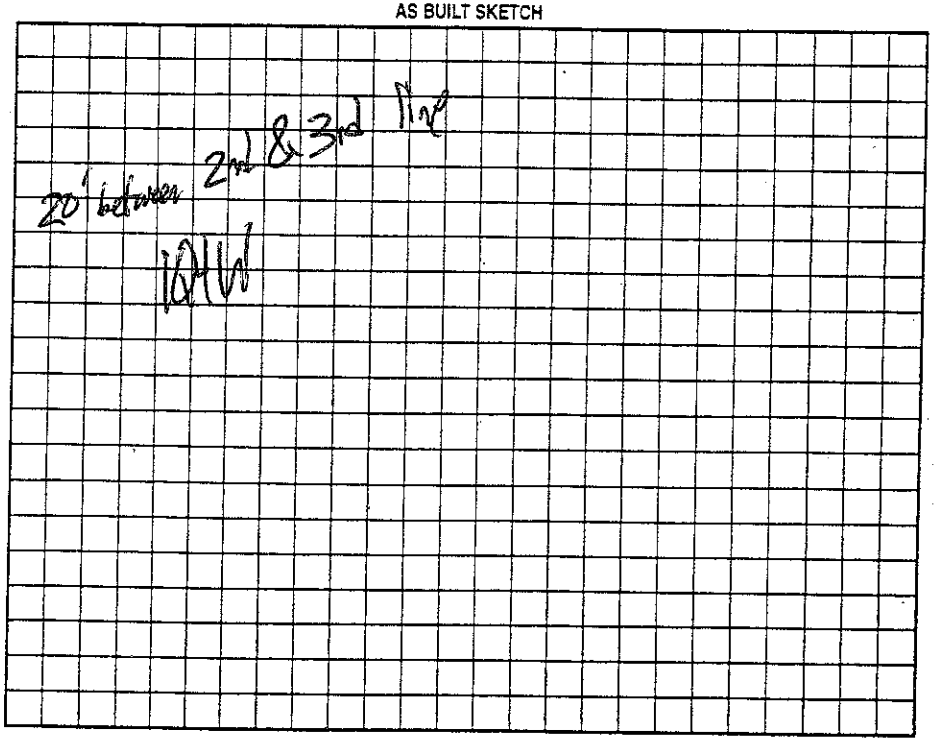

Permit can be suspended or revoked if any false information is supplied toward securing the permit/any unauthorized changes are made to the site/any unauthorized changes are made in the installation of the system. Improvement Permit with plat valid without expiration ☐ Improvement Permit with site plan valid for sixty months ☐ Authorization to Construct is valid for a period equal to that of Improvement Permit – not to exceed sixty months.

Signed: date

Improvement Permit by: date 12-19-06

Authorization to Construct by: date 12-19-06

Installed by: Brad Palmer

Operation Permit by: date 7-10-07

Existing System Inspection by: date

HEALTH DEPT. COPY: WHITE OWNER COPY (FINAL): YELLOW OWNER COPY (INITIAL): PINK