IREDELL COUNTY HEALTH DEPARTMENT

Statesville Office (704) 878-5305 Mooresville Office (704) 660-3625 PERMIT # 176404 DRK

IMPROVEMENT PERMIT / AUTHORIZATION TO CONSTRUCT / OPERATION PERMIT / EXISTING SYSTEM

PIN # 4746265667

APPLICANT: Champion Window Co of Greensboro APPLICANT ADDRESS: 7928 National Service Road Greensboro, NC 27409

SITE ADDRESS: 183 Devon Lane Statesville, NC 28625 PHONE: 336 393 0101 ALT. PHONE:

SITE DIRECTIONS: Hwy 21 N, (L) Shoemaker Dr, (L) Nixon, (L) Devon, property on (R)


SUBDIVISION: Iredell Heights SECTION: LOT # 25-28 LOT AREA: .44 DESIGN FLOW: 360 L.T.A.R.: .3

Septic Tank	1000 (gal)	STB	1012 (ex)	Date	11-27-05	☒ New System	☐ Repair	☐ Expansion	System Type: I II (III) IV V VI	☒ Residence	No. Bedrooms 3
Pump Tank	(gal)	PT		Date		System Description:	25% Reduction Gravity			☐ Business	No. Persons
Pump Make		Model		Serial #		Repair System Description:	50% Reduction LPP			☐ Other	No. Employees
# Nitrification Fields	1	# Lines	1 (5 tot)	Linear Ft:	15 (360) tot	Maintenance Agreement Required:	☐ YES	☒ NO		☐ Slab	☒ Crawl Space
Trench Width	36"	Max. Trench Bottom Depth	36"	Gravel Depth	n/a		☒ GRAVITY	☐ PRESSURE		☐ Basement w/plumbing	☐ Basement w/o plumbing


Water Supply: ☐ Private ☒ Public ☐ Community

Comments / Conditions: Remove 1 chamber each on 4th and Fifth line, and add 15ft to system on a new sixth line. Remove drop boxes on 4th and 5th lines and connect lines 4,5,6 via endcap distribution. No part of system shall be closer than 5' to ANY Building Foundation.

INITIAL SITE SKETCH

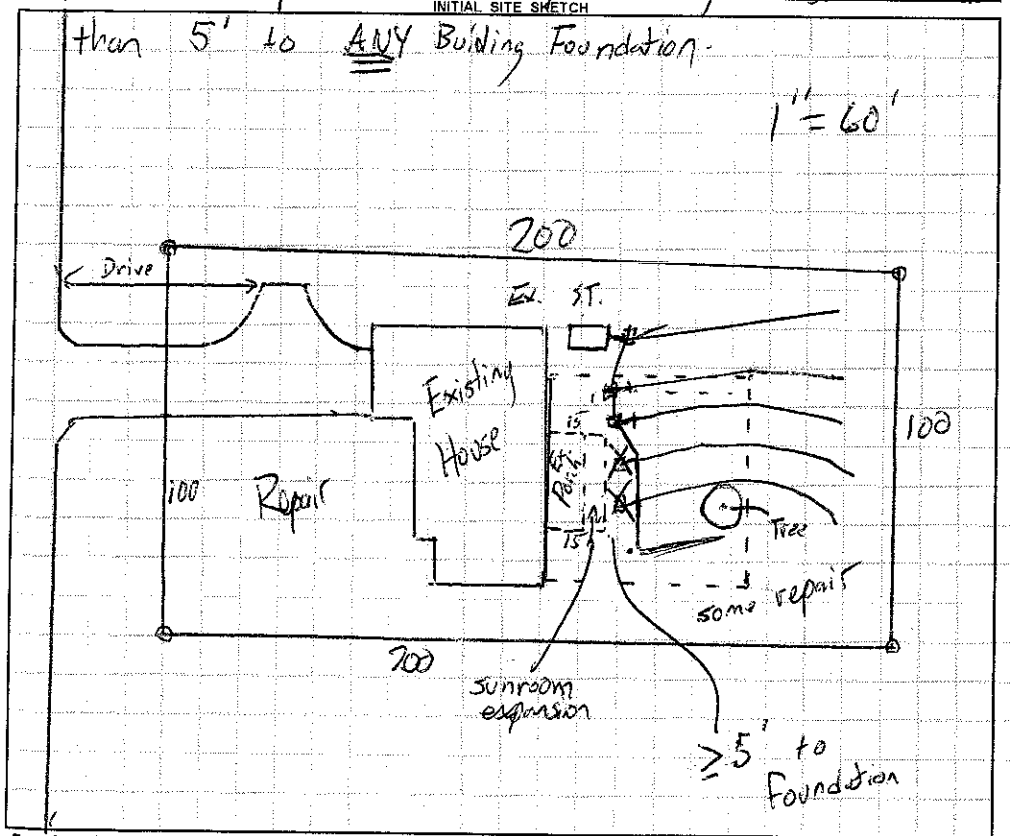

AS BUILT SKETCH

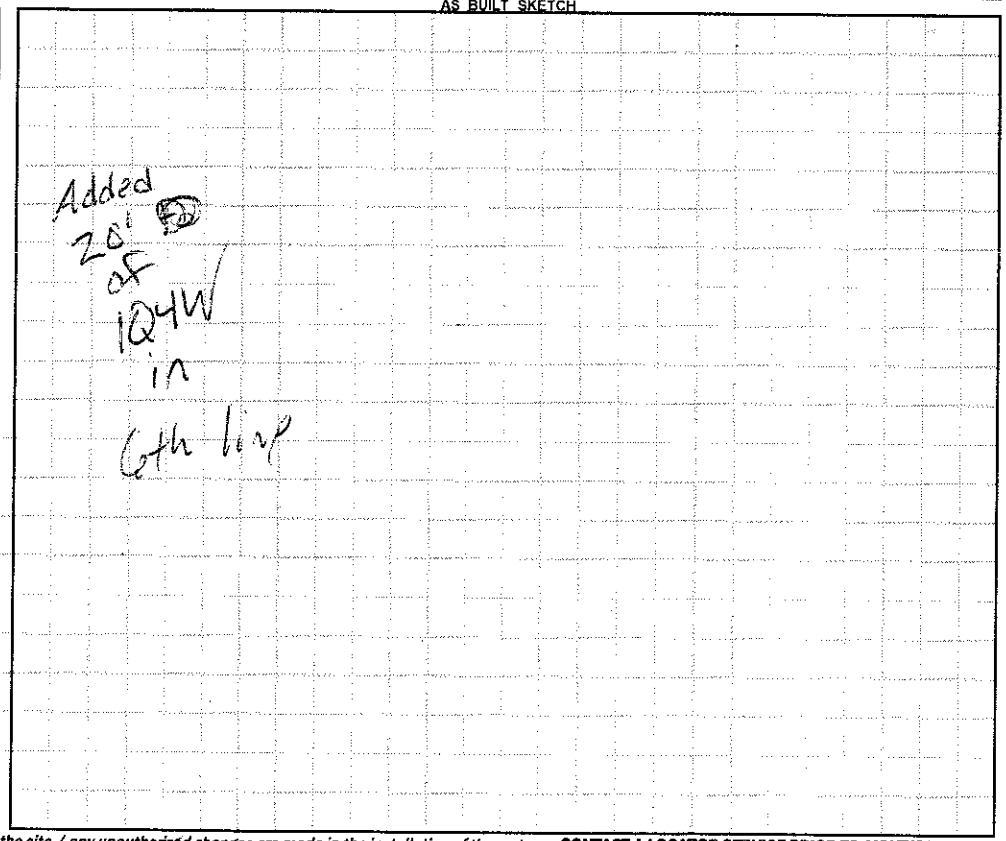

Permit can be suspended or revoked if any false information is supplied toward securing the permit / any unauthorized changes are made to the site / any unauthorized changes are made in the installation of the system. **CONTACT A LOCATOR SERVICE PRIOR TO ANY EXCAVATION**

☐ **IMPROVEMENT PERMIT** *with plat valid without expiration.* ☒ **IMPROVEMENT PERMIT** *with site plan valid for 60 mos.* ☒ **AUTHORIZATION TO CONSTRUCT** *valid for period equal to IMPROVEMENT PERMIT--not to exceed 60 mo.*

Owner / Applicant Signature: Date: 2-7-13 Installed by: Wes Lytton

IMPROVEMENT PERMIT by: Date: 2-7-13 OPERATION PERMIT by: Date: 2-20-13

AUTHORIZATION TO CONSTRUCT by: Date: 2-7-13 Existing System Inspected by: Date:

Health Dept. Copy - WHITE Applicant (Final Approval) - YELLOW Applicant (Conditional Approval) - PINK