IREDELL COUNTY HEALTH DEPARTMENT

Statesville Phone TR 3-7271 Mooresville Phone NO 3-1271

PERMIT TO INSTALL SEPTIC TANK

Permit No. 102 Permit Date 2-15 1972

Owner ROBERT WHITE Address STATESVILLE, N.C

Installed By York Rutty Address Stony Point, NC

Location of Property IREDELL HEIGHTS


WEST CORNER NIXON Rd + DEVON Rd.

| Tank | | Capacity | | Length of Lines | | Fixtures | |
|---|---|---|---|---|---|---|---|
| Block | ( ) | 1000 | (✓) | 225' | (✓) | No. of Baths | (1½) |
| Precast | (✓) | 1250 | ( ) | 250' | ( ) | Dishwasher | ( ) |
| | | 1500 | ( ) | Other | | Garbage Grdr. | ( ) |
| | | Other | | | | Other | |

NOTIFY HEALTH DEPARTMENT AT LEAST EIGHT HOURS BEFORE TANK IS TO BE INSPECTED.

Final Inspection 2-15 1972 Approved (✓) Disapproved ( )

Remarks IREDELL WATER Corp.

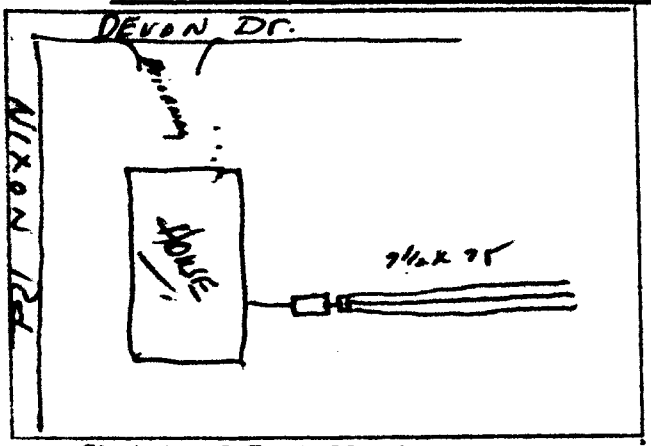


Sketch of Installation

Sanitarian