IREDELL COUNTY HEALTH DEPARTMENT

Statesville Phone TR 3-7271 Mooresville Phone NO 3-1271

PERMIT TO INSTALL SEPTIC TANK

Permit No. 119 Permit Date 3-1 1972

BLOCK ALFRED LEVAN

Owner DANNY WALDRUP Address STATESVILLE, NC

Installed By HERMAN GIBSON Address STATESVILLE, NC

Location of Property IREDELL HEIGHTS -

DEVON Rd -


LOTS NO. 54-55-56-107

Tank		Capacity		Length of Lines		Fixtures	
Block	( )	1000	(✓)	225'	(✓)	No. of Baths	(1½)
Precast	(✓)	1250	( )	250'	( )	Dishwasher	( )
		1500	( )	Other		Garbage Grdr.	( )
		Other				Other	

NOTIFY HEALTH DEPARTMENT AT LEAST EIGHT HOURS BEFORE TANK IS TO BE INSPECTED.

Final Inspection 3-1 1972 Approved (✓) Disapproved ( )

Remarks IREDELL WATER CORP

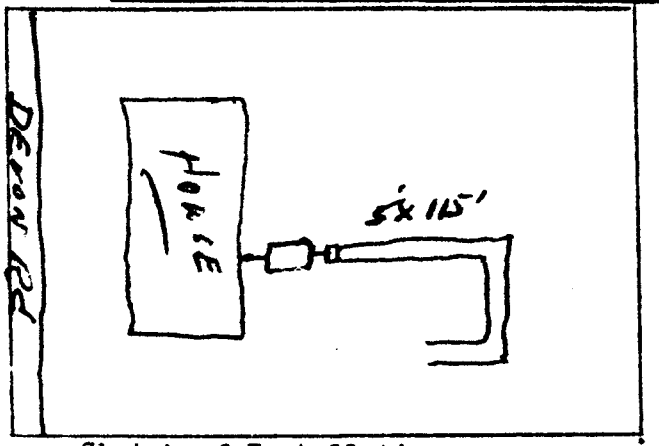

Sketch of Installation

Sanitarian