IREDELL COUNTY HEALTH DEPARTMENT

Statesville Phone TR 3-7271 Mooresville Phone NO 3-1271

PERMIT TO INSTALL SEPTIC TANK

Permit No. 67 Permit Date _____ 19___

Owner Alfred Levan Address Statesville N.C.

Installed By Herman Gibson Address Statesville N.C


Location of Property Out Hwy 21 N to Rd 1922 T.L. T.L. on Debbie Lane T.L. Dwon Lane T.R. on Dawon Road House on R. Lot # 53 (Iredell Heights)

Tank		Capacity		Length of Lines		Fixtures	
Block	( )	1000	(✓)	225'	(✓)	No. of Baths	(1½)
Precast	(✓)	1250	( )	250'	( )	Dishwasher	( )
		1500	( )	Other _____		Garbage Grdr.	( )
		Other _____				Other _____	

NOTIFY HEALTH DEPARTMENT AT LEAST EIGHT HOURS BEFORE TANK IS TO BE INSPECTED.

Final Inspection 1-21 1972 Approved (✓) Disapproved ( )

Remarks Iredell Water Corp.

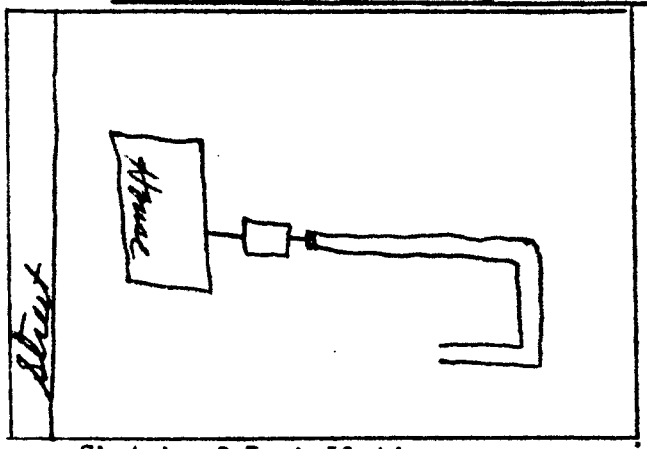

Sketch of Installation

E. G. Stevenson

Sanitarian