IREDELL COUNTY HEALTH DEPARTMENT

Statesville Phone TR 3-7271 Mooresville Phone No. 664-5281

PERMIT TO INSTALL SEPTIC TANK

Permit No. 429 Permit Date 5-31 1973

Bldr.

Owner JEFF HORNE Address STATESVILLE, NC.

Installed By York Rufty Address Stony Point, NC.


Location of Property DEVON DR. 5TH HOUSE ON E SIDE OF LEAT FROM NIXON RD - IREDELL HEIGHTS —

Tank		Capacity		Length of Lines		Fixtures	
Block	(✓)	1000	(✓)	225'	(✓)	No. of Baths	(1½)
Precast	(✓)	1250	( )	250'	( )	Dishwasher	( )
		1500	( )	Other		Garbage Grdr.	( )
		Other				Other	

NOTIFY HEALTH DEPARTMENT AT LEAST EIGHT HOURS BEFORE TANK IS TO BE INSPECTED.

Final Inspection 5-31 1973 Approved (✓) Disapproved ( )

Remarks IREDELL WATER CORP.

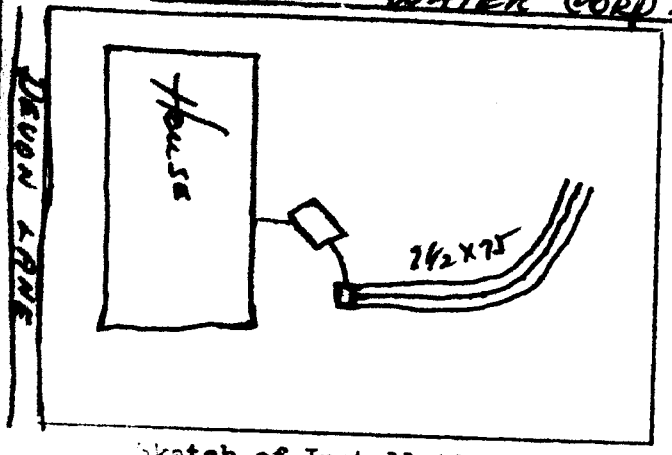

Sketch of Installation

Field filled with surface water
Cleaned out dirt and
covered with straw.

Sanitarian