IREDELL COUNTY HEALTH DEPARTMENT

Statesville Phone TR 3-7271 Mooresville Phone No. 664-5281

PERMIT TO INSTALL SEPTIC TANK

Permit No. 226 Permit Date 2-26 1973

Owner Bldr. JEFF HORNE Address STATESVILLE, NC

Installed By YORK RUFTY Address Stony Point, NC

Location of Property IREDELL HEIGHTS

DEVON DR. 6th House on LF from


NIXON Rd.) (1-B)

Tank		Capacity		Length of Lines		Fixtures	
Block	( )	1000	(✓)	225'	(✓)	No. of Baths	(1½)
Precast	(✓)	1250	( )	250'	( )	Dishwasher	( )
		1500	( )	Other		Garbage Grdr.	( )
		Other				Other	

NOTIFY HEALTH DEPARTMENT AT LEAST EIGHT HOURS BEFORE TANK IS TO BE INSPECTED.

Final Inspection 2-26 1973 Approved (✓) Disapproved ( )

Remarks IREDELL WATER CO.

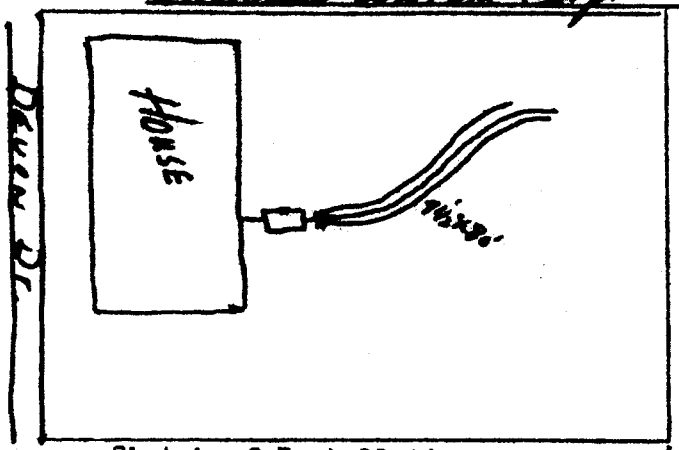

Sketch of Installation

Glenn Todd

Sanitarian