IREDELL COUNTY HEALTH DEPARTMENT

STATESVILLE 704-878-5305 MOORESVILLE 704-664-5281

IMPROVEMENT PERMIT / AUTHORIZATION TO CONSTRUCT / OPERATION PERMIT / EXISTING SYSTEM INSPECTION

PERMIT# REPAIR PIN# 4746-26-8515 DATE 3.15.02

OWNER OR CONTRACTOR BENTLEY T. & ALICE HARWELL PHONE: Business 704-902-1787 Home 704-876-0819

ADDRESS 180 DEVON LANE, STATESVILLE, NC 28625-8905

LOCATION NC 115 N TR S. CHIPLEY FORD RD, TR NIXON RD, TR DEVON LANE, 3RD LOT ON LEFT

SUBDIVISION IREDELL HEIGHTS BLOCK / SECTION 1 LOT 33-37 LOT AREA 125' x 180' SITE CLASS PS DESIGN FLOW 360 L.T.A.R. EXISTING

Septic Tank: 1000 Gallons: STB 1012 Date 10-9-01
Pump Tank: ____ Gallons: PT ____ Date ____
Pump Make: ____ Model ____ Serial No ____
Nitrification Field: No Fields 1 Square Feet 450 Linear Feet 150'
No Lines ONE Trench Width 36" Max Trench Bottom Depth 36" Gravel Depth 18"

☐ New System ☑ Repair System Type: I, II, III, IV, V, VI
System Description: CONVENTIONAL, GRAVITY
Repair System Description: CONVENTIONAL, GRAVITY
Maintenance Agreement Required: ☐ Yes ☑ No

☑ House/Mod Home ☐ Mobile Home ☐ Business ☐ Other
No. Bedrooms 3 No. Bathrooms 1½ No. Employees ____


☐ Slab ☑ Crawl Space ☐ Basement w/plumbing ☐ Basement wo/plumbing

Water Supply: ☐ Individual ☑ Public ☐ Community

Comments/Conditions: INSTALL NEW SEPTIC TANK, ABANDON EXISTING SEPTIC TANK. INSTALL NEW 3' x 150' LINE ON CONTOUR AS FLAGGED USING 18" STONE

Comments/Conditions: SEPTIC TANK WITH MARKER INSTALLED USING "PolyLok" FILTER

INITIAL SITE SKETCH

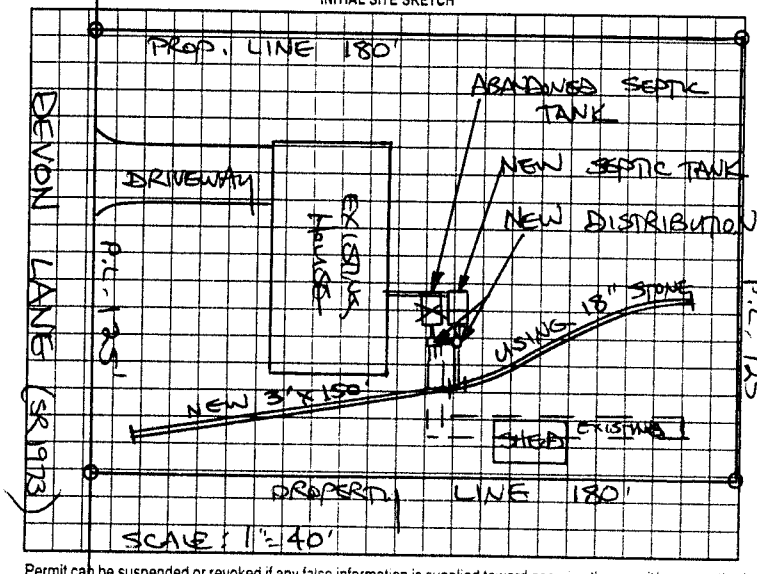

AS BUILT SKETCH

SYSTEM REPAIRED ACCORDING TO INITAL SITE SKETCH

Permit can be suspended or revoked if any false information is supplied toward securing the permit/any unauthorized changes are made to the site/any unauthorized changes are made in the installation of the system. Improvement Permit with plat valid without expiration. Improvement Permit with site plan valid for sixty months. Authorization to Construct is valid for a period equal to that of Improvement Permit – not to exceed sixty months.

Signed: Allen Bentley Harwell date 3/15/02 Installed by: STEVE JORDAN

Improvement Permit by: STEVE HEDRICK date 3.15.02 Operation Permit by: STEVE HEDRICK date 3-25-02

Authorization to Construct by: STEVE HEDRICK date 3.15.02 Existing System Inspection by: ____ date ____

HEALTH DEPT COPY WHITE OWNER COPY (FINAL) YELLOW OWNER COPY (INITIAL) PINK