IREDELL COUNTY HEALTH DEPARTMENT

STATESVILLE 704-878-5305 MOORESVILLE 704-664-5281

IMPROVEMENT PERMIT / AUTHORIZATION TO CONSTRUCT / OPERATION PERMIT / EXISTING SYSTEM INSPECTION

PERMIT# Repair PIN# 4746-26-9802 DATE 7/31/03

OWNER OR CONTRACTOR Chris + Alicia Hedrick PHONE: Business (Chris) (704) 881-0410 Home (704) 876-2078

ADDRESS 416 Nixon Rd Statesville N.C. 28625

LOCATION Hwy 21 N, @ Shuemaker Rd, @ Nixon Rd on Left @ 416 Nixon

SUBDIVISION Fredell Heights BLOCK / SECTION - LOT 134 LOT AREA 209 x 120 SITE CLASS. PS DESIGN FLOW 400 L.T.A.R. .25 gpd/ft²

Septic Tank: Existing Gallons; STB ____ Date ____

Pump Tank: 1,000 Gallons; PT 17 Date 1-24-03

Pump Make: Gould Model WE0311M Serial No. M0256237

Nitrification Field: No Fields 1 Square Feet ____ Linear Feet 400'

No Lines 4 @ 100' Trench Width 36" Max Trench Bottom Depth 32" Gravel Depth NA

☐ New System ☒ Repair System Type: I, II, (III), IV, V, VI

System Description: ____

Repair System Description: Pump, 25% Reduction

Maintenance Agreement Required: ☐ Yes ☒ No

☒ House/Mod. Home No. Bedrooms 3

☐ Mobile Home No. Bathrooms 1½

☐ Business No. Employees ____

☐ Other ____


☐ Slab ☒ Crawl Space ☐ Basement w/plumbing ☐ Basement wo/plumbing

Water Supply: ☐ Individual ☒ Public ☐ Community


Comments/Conditions: (1) Install new P.T. + System as designed (2) This permit serves as Notice of Violation, 30 days to repair System From 8-1-03. (3) See Attachment A" for ST.

Comments/Conditions: S.T. pumped out. Septic Tank in Fair Condition, may need to be replaced. up Horn + Electrical okay, Pressure Check + timer okay.

INITIAL SITE SKETCH

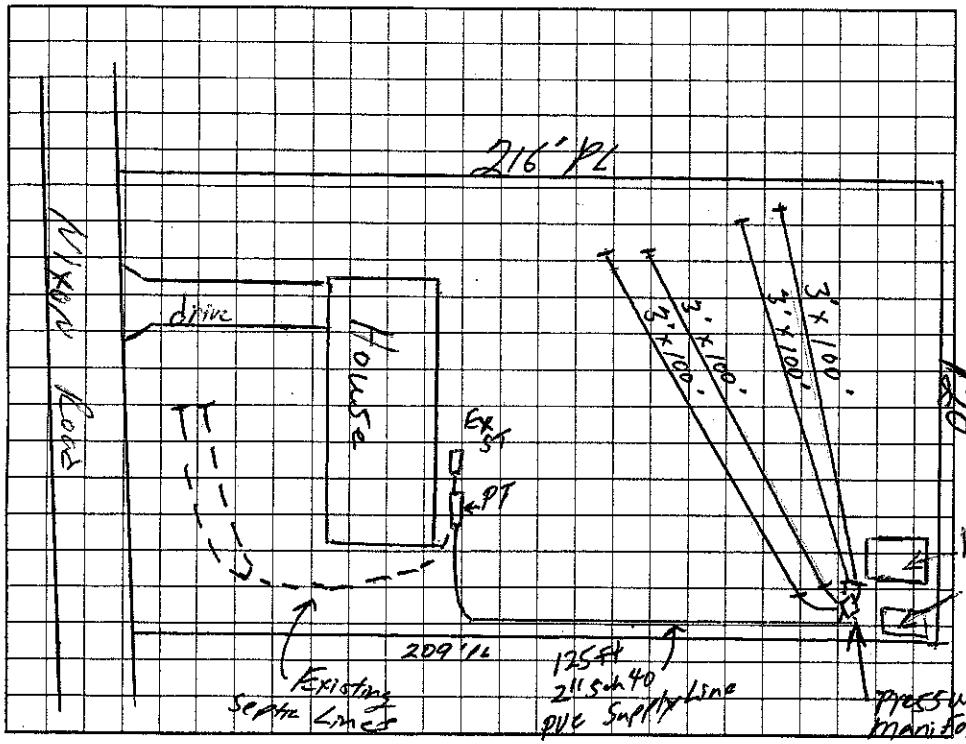

AS BUILT SKETCH

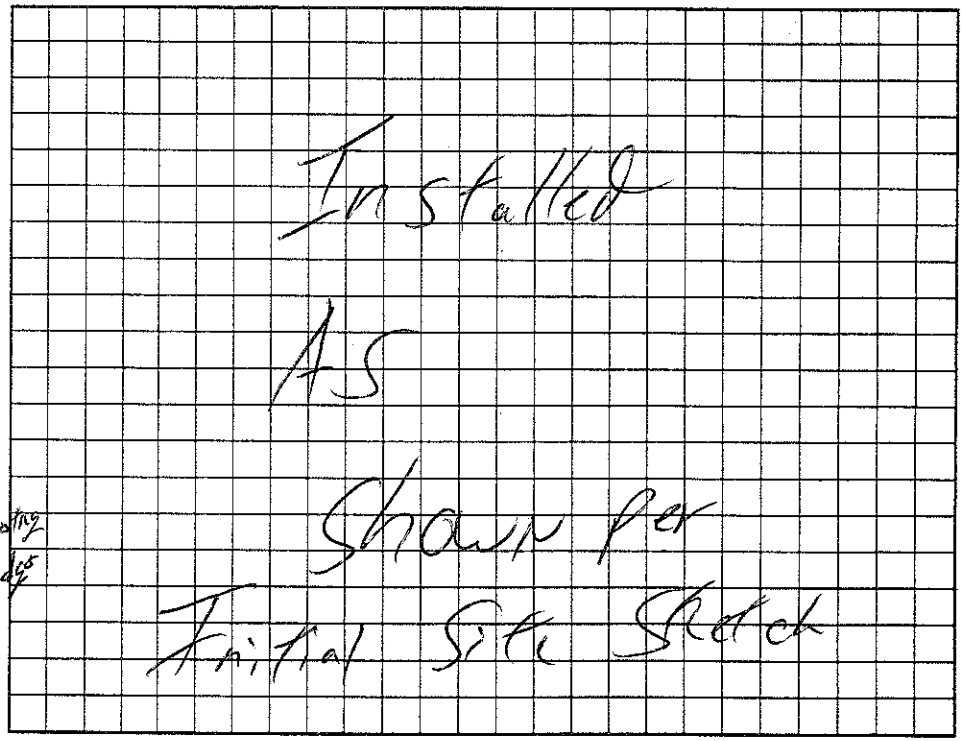

Permit can be suspended or revoked if any false information is supplied toward securing the permit/any unauthorized changes are made to the site/any unauthorized changes are made in the installation of the system. Improvement Permit with plat valid without expiration, Improvement Permit with site plan valid for sixty months. Authorization to Construct is valid for a period equal to that of Improvement Permit -- not to exceed sixty months.

Signed: Alicia H. Hedrick date 8/1/03

Improvement Permit by: William O. Johnson date 7/31/03

Authorization to Construct by: William O. Johnson date 7/31/03

Installed by: A-1 Backhoe

Operation Permit by: William O. Johnson date 9/22/03

Existing System Inspection by: ____ date ____

HEALTH DEPT. COPY: WHITE OWNER COPY (FINAL): YELLOW OWNER COPY (INITIAL): PINK