IREDELL COUNTY HEALTH DEPARTMENT

STATESVILLE 704-878-5305 MOORESVILLE 704-664-5281

IMPROVEMENT PERMIT / AUTHORIZATION TO CONSTRUCT / OPERATION PERMIT / EXISTING SYSTEM INSPECTION

PERMIT# 83962 PIN# 4746270723 DATE 11-24-99

OWNER OR CONTRACTOR David Holman PHONE: Business Home 875-8526

ADDRESS 11510 Asbury Chapel Rd Huntersville N.C.

LOCATION 115 N TR Chipley Ford TR Nixon 1.5 miles on left

SUBDIVISION BLOCK / SECTION LOT LOT AREA 16.36 acres SITE CLASS PS DESIGN FLOW 480 L.T.A.R. .3 galls/day

Septic Tank: 1000 Gallons; STB 1012 Date 4-8-01

Pump Tank: Gallons; PT Date

Pump Make: Model Serial No.

Nitrification Field: No Fields 1 Square Feet 1600 Linear Feet 533

No Lines 4 Trench Width 36" Max Trench Bottom Depth 36" Gravel Depth 12"

☑ New System ☐ Repair System Type: I, II, III, IV, V, VI

System Description: Conv. Gravity

Repair System Description:

Maintenance Agreement Required: ☐ Yes ☑ No

☑ House/Mod. Home ☐ Mobile Home ☐ Business ☐ Other

No. Bedrooms 4 No. Bathrooms 3½ No. Employees

☐ Slab ☐ Crawl Space ☑ Basement w/plumbing ☐ Basement wo/plumbing

Water Supply: ☐ Individual ☑ Public ☐ Community


Comments./Conditions: 3481

Comments./Conditions: POLY LOK FILTER & MARKER INSTALLED AS SHOWN

1331'

INITIAL SITE SKETCH

AS BUILT SKETCH

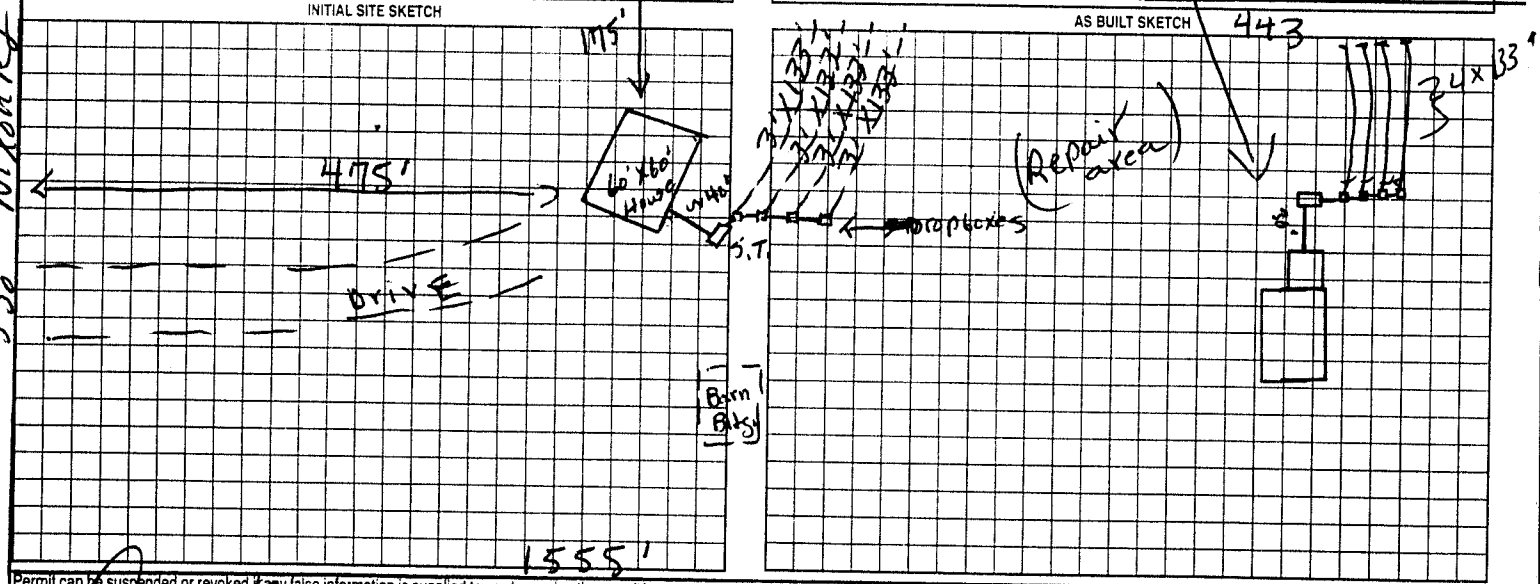

Permit can be suspended or revoked if any false information is supplied toward securing the permit/any unauthorized changes are made to the site/any unauthorized changes are made in the installation of the system. Improvement Permit with plat valid without expiration. Improvement Permit with site plan valid for sixty months. Authorization to Construct is valid for a period equal to that of Improvement Permit – not to exceed sixty months.

Signed: date 05/15/00 Installed by: STEVE JORDAN

Improvement Permit by: P. C. Moore date 11-24-99 Operation Permit by: date 8-23-01

Authorization to Construct by: P. C. Moore date 11-24-99 Existing System Inspection by: date

HEALTH DEPT COPY: WHITE OWNER COPY (FINAL): YELLOW OWNER COPY (INITIAL): PINK