IREDELL COUNTY HEALTH DEPARTMENT

Statesville Phone TR 3-7271 Mooresville Phone No. 664-

PERMIT TO INSTALL SEPTIC TANK

Permit No. _____ Permit Date 6 - 22 1973

Owner Bldr. BILL ANDERSON Address STATESVILLE -

Installed By Roy Lenly Address R.5 Statesville


Location of Property 2½ m. left on Shumaker Rd - Indian Heights. Left on Nixon Rd. House on N/W corner Polly Dr & Nixon Rd

Tank		Capacity		Length of Lines		Fixtures	
Block	( )	1000	(✓)	225'	( )	No. of Baths	(1½)
Precast	(✓)	1250	( )	250'	( )	Dishwasher	(✓)
		1500	( )	Other 240		Garbage Grdr.	( )
		Other _____				Other _____	

NOTIFY HEALTH DEPARTMENT AT LEAST EIGHT HOURS BEFORE TANK IS TO BE INSPECTED.

Final Inspection 6-22 1973 Approved (✓) Disapproved ( )

Remarks Indian Water Corp

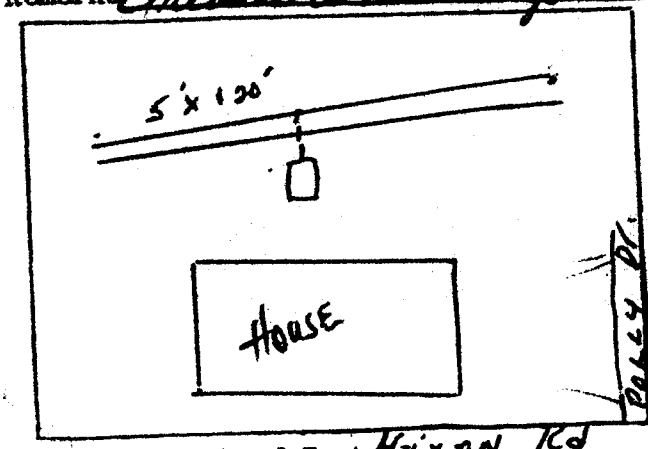

Sketch of Installation

Sanitarian