ICHD - ENVIRONMENTAL HEALTH DIVISION

Statesville Office (704) 878-5305 x3456 | Mooresville Office (704) 660-3625

SEPTIC: IMPROVEMENT PERMIT / AUTHORIZATION TO CONSTRUCT / OPERATION PERMIT / EXISTING SYSTEM

PERMIT : OSWP- 2024-50324

PIN # 4746 -- 29 -- 7271

APPLICANT/OWNER: JOHN P. JONES | APPLICANT ADDRESS: 1536 YADKIN STREET, STATESVILLE, N.C. 28677

SITE ADDRESS: 169 CASTLE CREEK ROAD, STATESVILLE, N.C. 28625 | PHONE: 704-818-8159 | ALT. PHONE —

SITE DIRECTIONS: (N) ON 21, (L) ON SHUMAKER, (L) ON CASTLE CREEK, LOT ON (L) | SAP CONTROLLED: ☐ YES ☐ NO EXT

SUBDIVISION: KINGSWOOD ESTATE | SECTION: — | LOT # 24 | LOT AREA: 0.488ac | DESIGN FLOW: EXT | L.T.A.R.(Initial): EXT | L.T.A.R (Repair): EXT

Septic Tank	1000 (gal)	STB	2152	Date	[illegible]	☐ New System	☑ Repair	☐ Expansion	System Type: I (II) III IV V VI
Pump Tank	— (gal)	PT	—	Date	—	System Description:	EXISTING - CONVENTIONAL		
Pump Make	—	Model	—	Serial #	—	Repair System Description:	TANK REPLACEMENT		
# Nitrification Fields	EXT	# Lines	EXT	Linear Ft	EXT	Maintenance Agreement Required:	☐ YES	☑ NO	
Trench Width	EXT	*Max. Trench Depth(Initial)	EXT	*Max. Trench Depth(Repair)	EXT	Gravel Depth	EXT	☑ GRAVITY	☐ PRESSURE

* Measured on the downhill side of the trench | Effluent Standard: ☑ DSE ☐ HSE ☐ TS-I ☐ TS-II ☐ RCW ☐ NSF/ANSI 40 | Usable Depth to LC (Initial): EXT | Usable Depth to LC (Repair): EXT


☑ Residence | No. Bedrooms: EXT | ☐ Business | No. Persons: EXT | ☐ Other | No. Employees: — | ☐ Slab | ☐ Crawl Space | ☐ Basement w/plumbing | ☑ Basement w/o plumbing

Water Supply: ☐ Private ☑ Public ☐ Community

Limiting Condition

Comments / Conditions: PUMP, CRUSH, AND FILL EXISTING SEPTIC TANK, INSPECT AND REPLACE D-BOX AS NEEDED, DRAINFIELD FUNCTIONING AT TIME OF INSPECTION, DO NOT EXCEED 36 IN OF COVER ON NEW TANK


INITIAL SITE SKETCH

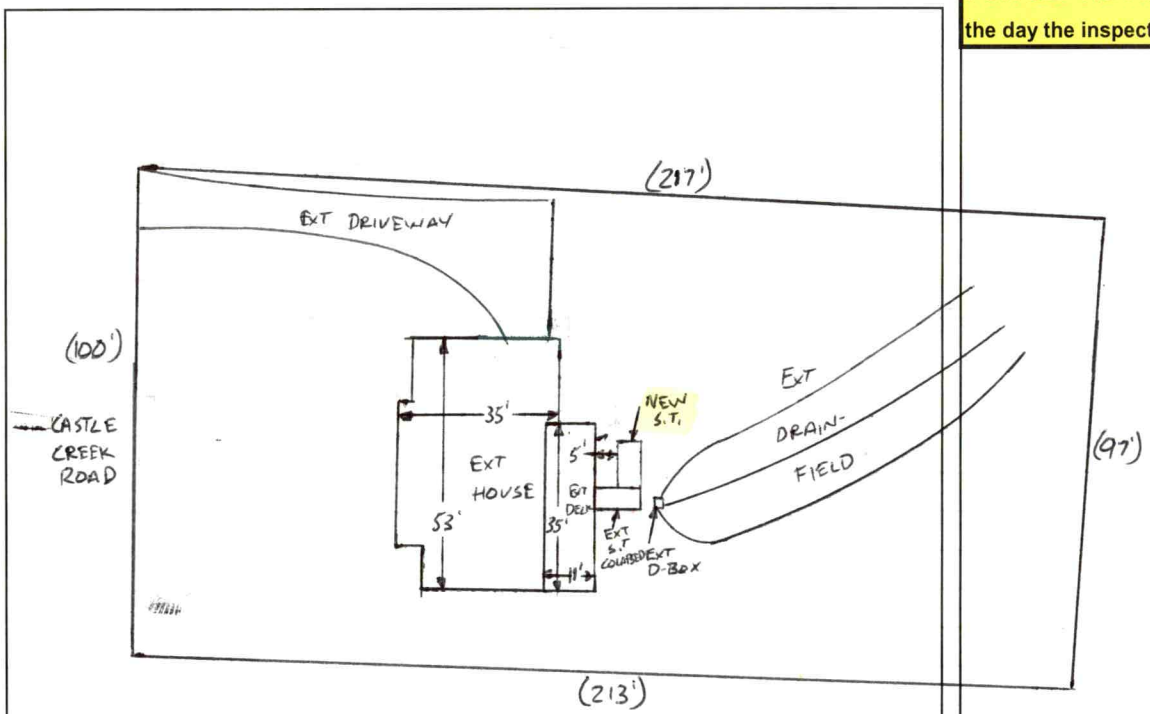

AS BUILT SKETCH

FOR SEPTIC FINAL INSPECTION CALL: 704-664-3703 between 8am-9am the day the inspection is needed. Be sure to speak with an inspector to confirm your time.

1 IN = 40 FT
S.T. = SEPTIC TANK
EXT = EXISTING

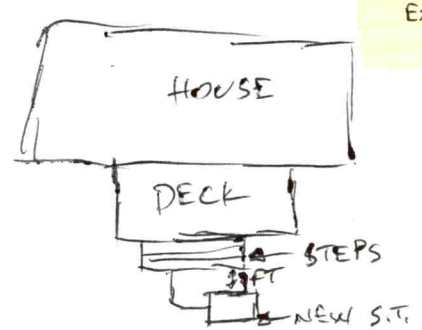

BCW 6-19-2024 — D. BOX TO BE INSPECTED CHECKED 6-20-2024

Permit can be suspended or revoked if any false information is supplied toward securing the permit / any unauthorized changes are made to the site / any unauthorized changes are made in the installation of the system. **CONTACT A LOCATOR SERVICE PRIOR TO ANY EXCAVATION**

☐ **IMPROVEMENT PERMIT** ***with plat*** *valid without expiration.* ☑ **IMPROVEMENT PERMIT** ***with site plan*** *valid for 60 mos.* ☑ **AUTHORIZATION TO CONSTRUCT** *valid for period equal to IMPROVEMENT PERMIT--not to exceed 60 mo.*


Owner / Applicant Signature: ONLINE SIGNATURE | Date: — | Installed by: CAROLINA SEPTIC PRO

IMPROVEMENT PERMIT by: Bryant C. White | Date: 4-17-2024 | OPERATION PERMIT by: Bryant C. White | Date: 6-20-2024

AUTHORIZATION TO CONSTRUCT by: Bryant C. White | Date: 4-17-2024 | Existing System Inspected by: — | Date: —

Item	Date	Initials
Drain Lines Checked		
Tanks Checked		
Pressure Manifold or Valve Box Checked		
Pressure Head Set		
Electrical Checked		
Floats Set		
Alarm Checked		
Maintenance Contract Needed? Y / N		
Comments:		

Repairs Only	
	State Code
Failing System Code	
Type of Distribution	G or P
Type of Failure/Malfunction	
Primary Cause of Failure/Malfunction	
Age of System? _____	
Initial or Repair? _____	

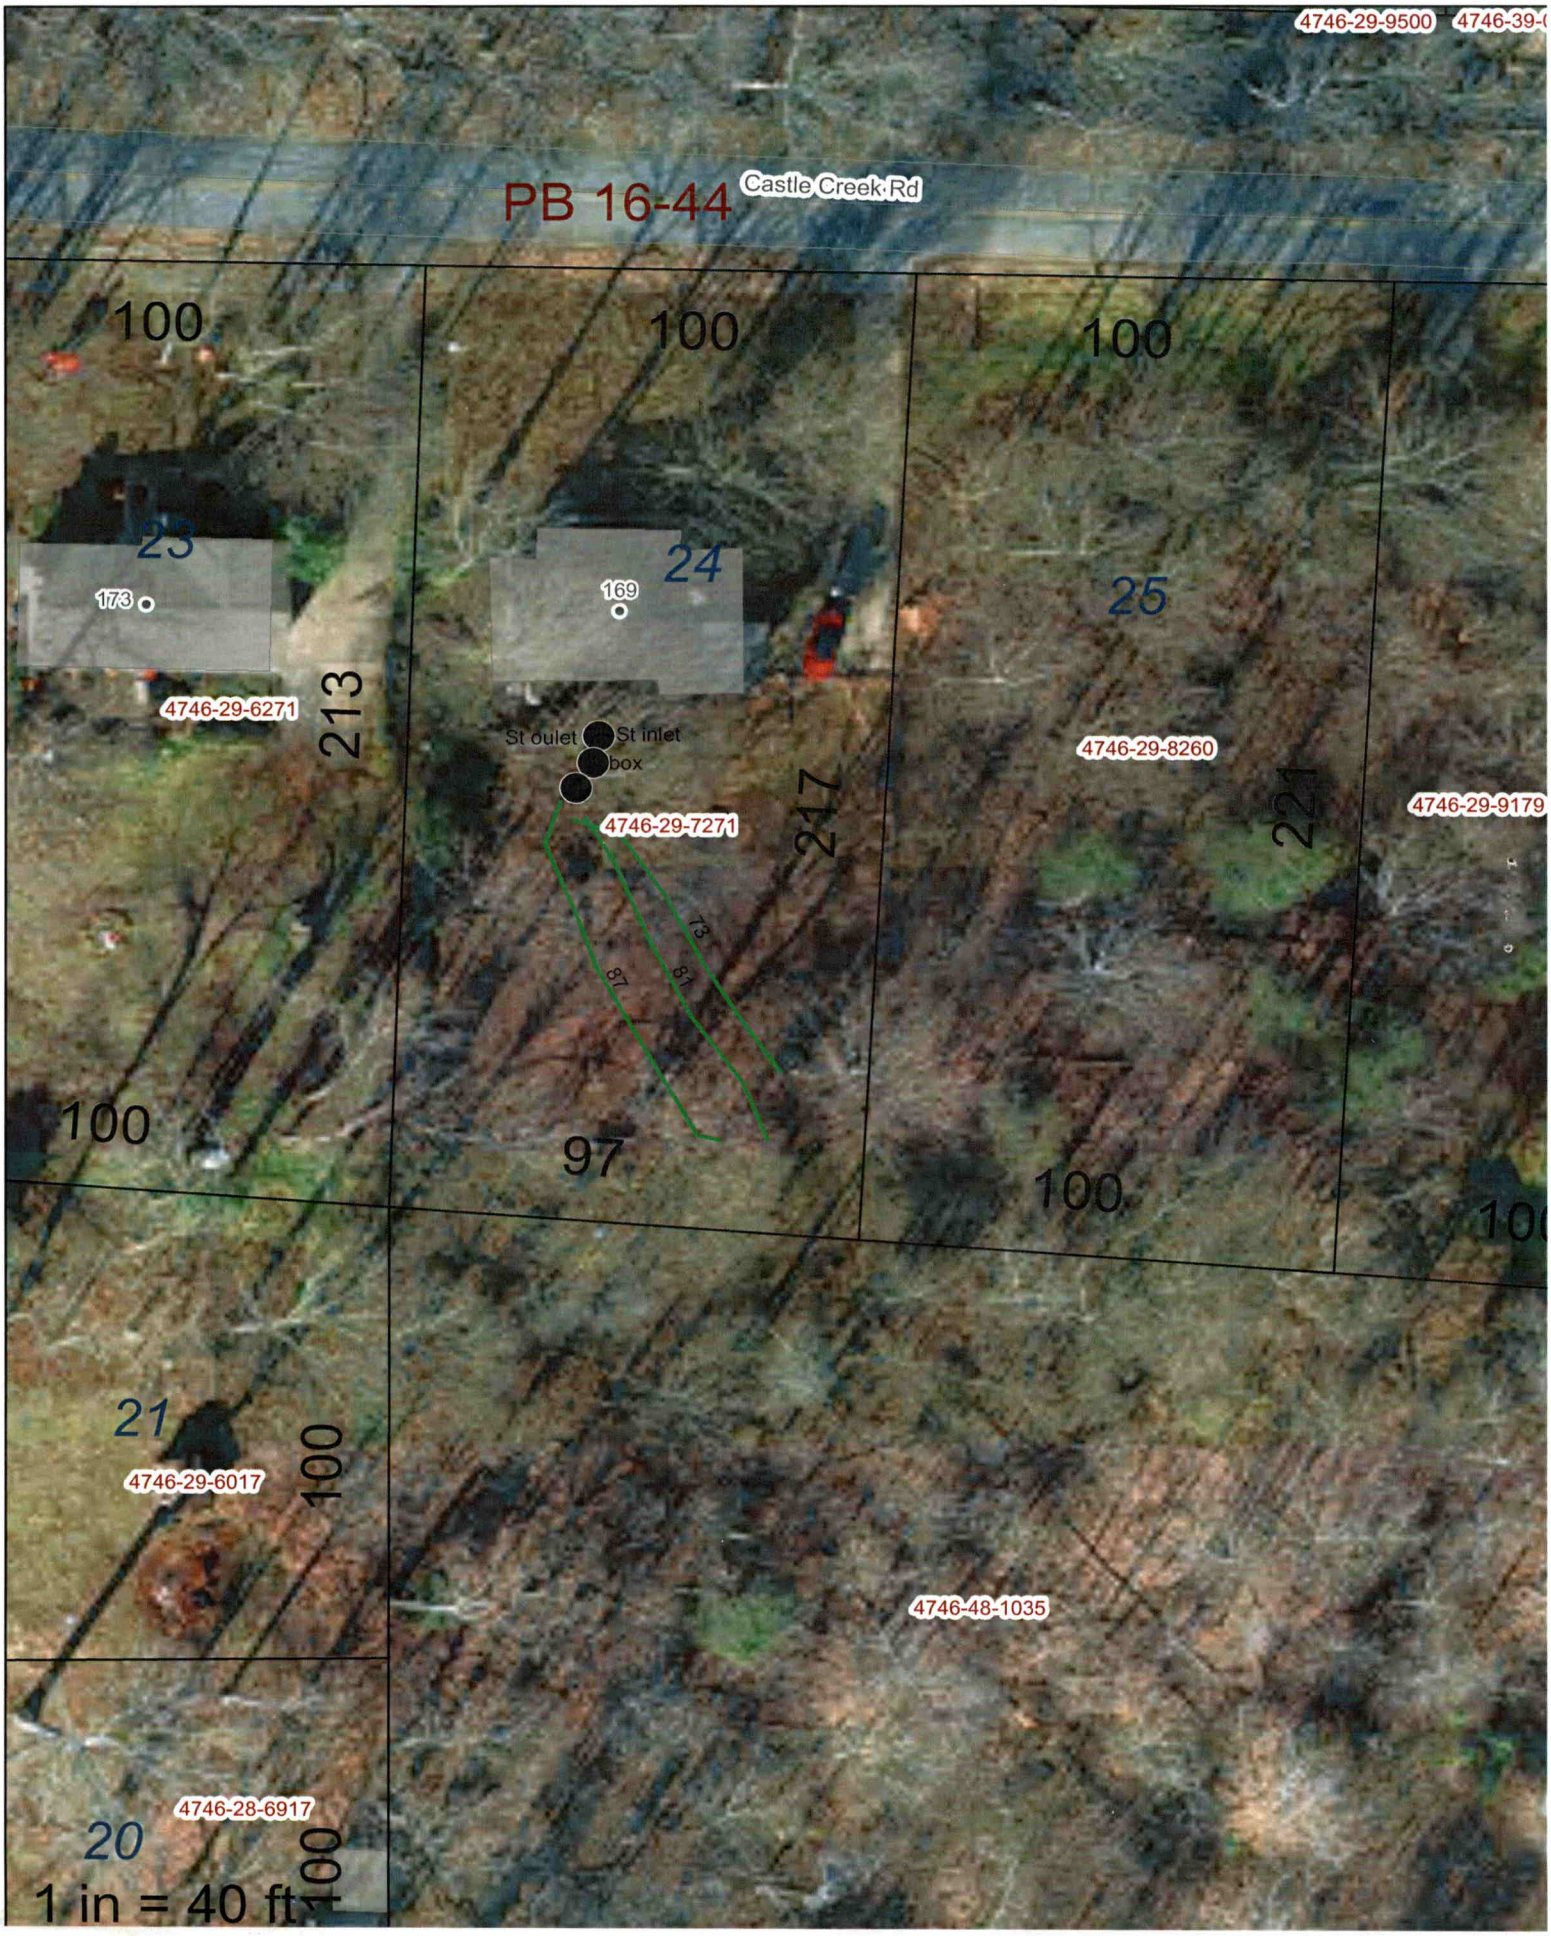
4746-29-9500
PB 16-44
Castle Creek Rd
100
100
100
23
24
25
173
169
4746-29-6271
213
St oulet
St inlet
box
4746-29-8260
4746-29-9179
4746-29-7271
217
221
73
81
87
100
97
100
21
4746-29-6017
100
4746-48-1035
20
4746-28-6917
100
1 in = 40 ft

PERMIT SNAPSHOT REPORT OSWP-2024-50324 FOR IREDELL COUNTY

Permit Type	Environmental Health OSWP	**Project:**		**App Date:**	04/01/2024
Work Class:	EH Septic Permit	**District:**	Iredell County	**Exp Date:**	NOT AVAILABLE
Status:	PRIORITY PERMIT	**Square Feet:**	0.00	**Completed:**	NOT COMPLETED
Valuation:	$0.00	**Assigned To:**	White, Bryant	**Approval Expire Date:**	
Description:	Septic tank lid busted and tank is exposed -				

Parcel: 4746297271.000 Main	**Address:** 169 Castle Creek Rd Statesville, NC 28625 Main	**Zone:** R-20(Suburban Residential District)

Property Owner	Applicant/Authorized Agent
John P Jones	John P Jones
1536 Yadkin Street	1536 Yadkin Street
Statesville, NC 28677	Statesville, NC 28677

Permit Custom Fields


How is your site plan being submitted	Custom Site Plan	Septic Application/Permit Type	Repair	Does the site contain any jurisdictional wetlands	No
Non-domestic Sewage Generated	No	Other Public Agency	No	All proposed structure dimensions	1400 sq. ft.
What are the proposed structures	New Single-Family Residence - Stick Built	Type of New Single-Family Residence	Stick Built	Maximum Number of Bedrooms	3
If other Addition/Structure, please explain		Number of Occupants	0	Foundation Type	Basement without Plumbing
Residential/Business/Other	Residential	Number of Employees	0	Water Supply	Other Public Water
Desired Septic System Type	Conventional (most common)	Additional Unique Setbacks Apply	No		

Attachment File Name	Added On	Added By	Attachment Group	Notes
Signature_John_Jones_4/1/2024.jpg	04/01/2024 18:03	Jones, John		Uploaded via CSS
IamPicaso_20240401_0001_v1.pdf	04/02/2024 15:25	Jones, John	Available Online	
DocToAuth_20240403_0001_v2.pdf	04/04/2024 8:21	Jones, John	Available Online	

Workflow Step / Action Name	Action Type	Start Date	End Date
Application Completeness Check v.1		04/04/2024 9:08	04/04/2024 9:08
Confirm application complete v.1	Generic Action		04/04/2024 9:08
~~**Zoning Review v.1**~~			04/04/2024 9:08
~~Floodplain Admin Overview v.1~~	Task		04/04/2024 9:08
~~Issue Invoice v.1~~	Generic Action		04/04/2024 9:08
~~Fees Paid v.1~~	Generic Action		04/04/2024 9:08
Fees v.1			
Issue Invoice v.1	Generic Action		
Fees Paid v.1	Generic Action		
Lot Readiness Verification v.1			
OSWP Septic Preliminary Site Visit v.1	Inspection		
OSWP Site Evaluation v.1	Inspection		
Issue Improvement Permit v.1			
Issue Invoice v.1	Generic Action		
Fees Paid v.1	Generic Action		

PERMIT SNAPSHOT REPORT (OSWP-2024-50324)

Issue Permit v.1	Generic Action
Permit Completion Process v.1	
Authorization to Construct Permit v.1	Create Sub Permit
Issue Authorization to Construct v.1	Generic Action

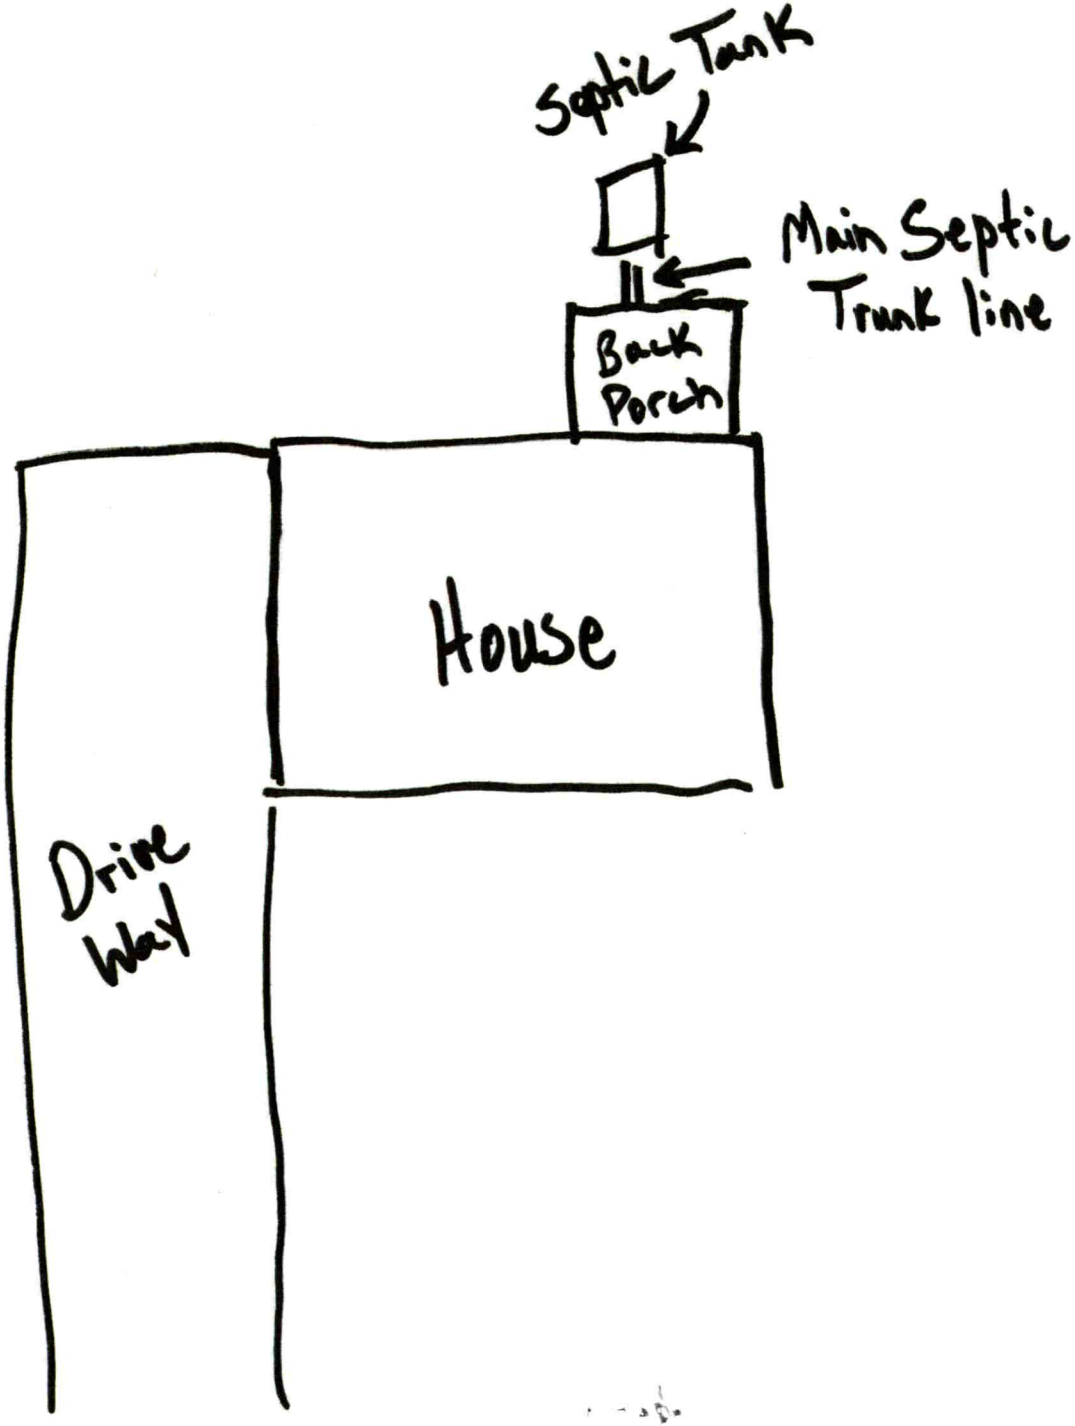
Septic Tank
Main Septic Trunk line
Back Porch
House
Drive Way