IREDELL COUNTY HEALTH DEPARTMENT

Statesville Phone TR 3-7271 Mooresville Phone No. 664-5281

PERMIT TO INSTALL SEPTIC TANK

Permit No. 11 Permit Date 6-5 1973

Owner C.W. Nicholson Address Statesville

Installed By Herman Gibson Address Statesville

Location of Property 21 N To ox Fort Dobbs Rd


2nd House on Right

Tank	Capacity	Length of Lines	Fixtures
Block	1000 ( )	225' ( )	No. of Baths ( )
Precast	1250 ( )	250' ( )	Dishwasher ( )
	1500 ( )	Other 200	Garbage Grdr. ( )
	Other		Other

NOTIFY HEALTH DEPARTMENT AT LEAST EIGHT HOURS BEFORE TANK IS TO BE INSPECTED.

Final Inspection 6-5 1973 Approved (✓) Disapproved ( )

Remarks

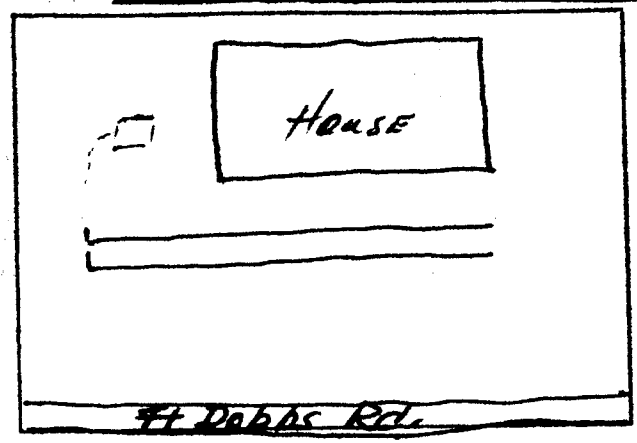

Sketch of Installation

Sanitarian