3:00

IREDELL COUNTY HEALTH DEPARTMENT

STATESVILLE 704-878-5305 MOORESVILLE 704-664-5281

IMPROVEMENT PERMIT / CERTIFICATE OF COMPLETION / OPERATION PERMIT / EXISTING SYSTEM INSPECTION

PROPERTY DESCRIPTION NO. _____ DATE 12-18-96 TAX MAP NO. _____ Watershed: ☐ Yes ☑ No

OWNER OR CONTRACTOR Darrell + Kay Robinette PHONE: Business _____ Home 873-1176

ADDRESS 130 Ft Dobbs Rd

LOCATION 21N TO Ft Dobbs Rd 1000' Rt

SUBDIVISION _____ BLOCK / SECTION _____ LOT _____ LOT AREA 3/4 acre SITE CLASS. PS DESIGN FLOW 360 L.T.A.R. 1.3

Septic Tank: EX. Gallons; STB _____ Date _____

Pump Tank: _____ Gallons; PT _____ Date _____

Pump Make: _____ Model _____ Serial No. _____

Nitrification Field: No Fields 2 Square Feet 600 Linear Feet 200

No Lines 3 Trench Width 36" Max Trench Bottom Depth 36" Gravel Depth N/A

☐ New System ☑ Repair System Type: I, II, III, IV, V, VI

System Description: Gravity

Repair System Description: Bull Run valve to Chamber

Maintenance Agreement Required: ☐ Yes ☐ No

☑ House/Mod. Home No. Bedrooms 3

☐ Mobile Home No. Bathrooms 2

☐ Business No. Employees ____

☐ Other _____


☐ Slab ☑ Crawl Space ☐ Basement w/plumbing ☐ Basement wo/plumbing

Water Supply: ☐ Individual ☐ Community ☑ Public


Comments:

Comments: Landscape + Pipe Gutters so That Surface water will not stand over Ex. or New Drain lines New lines are on No. 2 on valve switch every 6 mos.

INITIAL SITE SKETCH

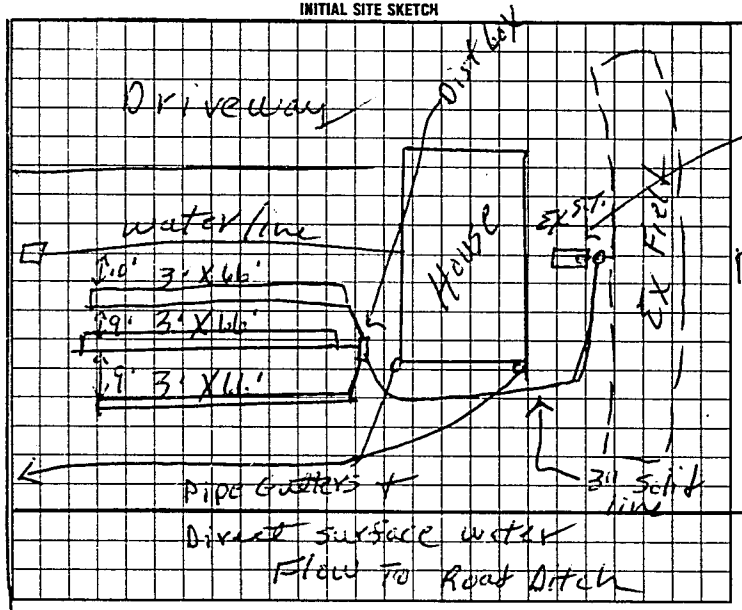

AS BUILT SKETCH

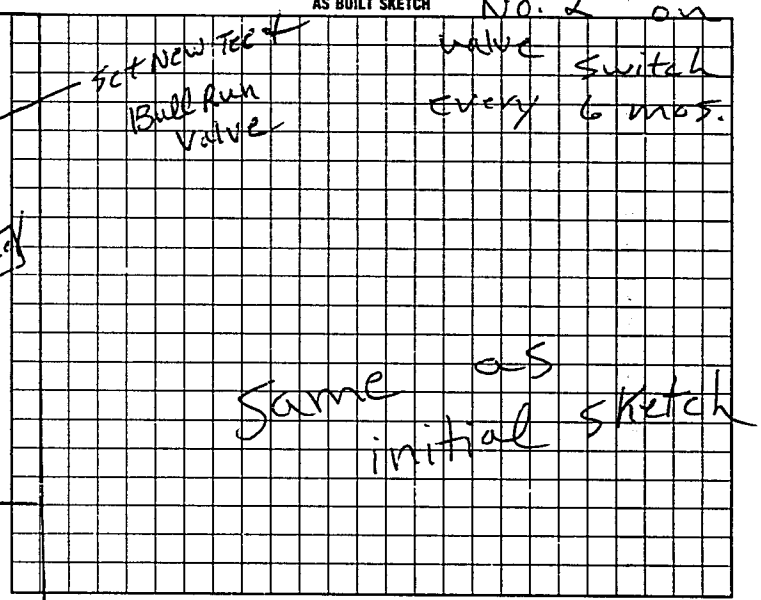

I understand that this permit can be suspended or revoked if any false information is supplied toward securing the permit/any unauthorized changes are made to the site/any unauthorized changes are made in the installation of the system. Improvement Permit is valid for 60 months from date of issuance.

Signed: X Kay J. Robinette Installed by: James Hutler

Improvement Permit by: P. C. Moore date 12-18-96 Certificate of Completion by: _____ date _____

Authorization Existing System Inspection by: P. C. Moore date 12-18-96 Operation Permit by: P. C. Moore date 2-25-97

to cover HEALTH DEPT. COPY: WHITE INSPECTION COPY (FINAL): GREEN OWNER COPY (FINAL): YELLOW INSPECTION COPY (INITIAL): PINK OWNER COPY (INITIAL): GOLD

Authorization to cover Expires 60 mos from issue

2 0 1 2 0 0