IREDELL COUNTY HEALTH DEPARTMENT

STATESVILLE 704-878-5305 MOORESVILLE 704-664-5281

IMPROVEMENT PERMIT / AUTHORIZATION TO CONSTRUCT / OPERATION PERMIT / EXISTING SYSTEM INSPECTION

PERMIT# 104397 PIN# 4946-32-01 90 DATE 2/13/02

OWNER OR CONTRACTOR CCS Inc PHONE Business (704) 880-4722 Home (704) 881-0510

ADDRESS 130 Dogwood Drive Statesville N.C. 28625

LOCATION Hwy 21 N Left on Rimmer Rd Lot #32 on Left

SUBDIVISION Fairview Farms BLOCK / SECTION — LOT 32 LOT AREA .68 Ac SITE CLASS 05 DESIGN FLOW 360 L.T.A.R. .35

Septic Tank: 4,000 Gallons: STB 1012 Date 2-11-02
Pump Tank: Gallons: PT Date
Pump Make: Model Serial No
Nitrification Field: No Fields 1 Square Feet 1029 Linear Feet 345
No Lines 3 Trench Width 36" Max Trench Bottom Depth 36" Gravel Depth 12"

X New System Repair System Type: I II III IV V VI
System Description: Gravity / Conventional
Repair System Description: Gravity/Rear/25% Red
Maintenance Agreement Required: Yes X No

X House/Mod. Home No. Bedrooms 3
Mobile Home No. Bathrooms 2
Business No. Employees
Other


X Slab Crawl Space Basement w/plumbing Basement wo/plumbing

Water Supply: ☐ Individual X Public ☐ Community

Comments /Conditions:

Comments /Conditions: POLYLOK FILTER & ANEVER INSTALLED AS SHOWN

INITIAL SITE SKETCH

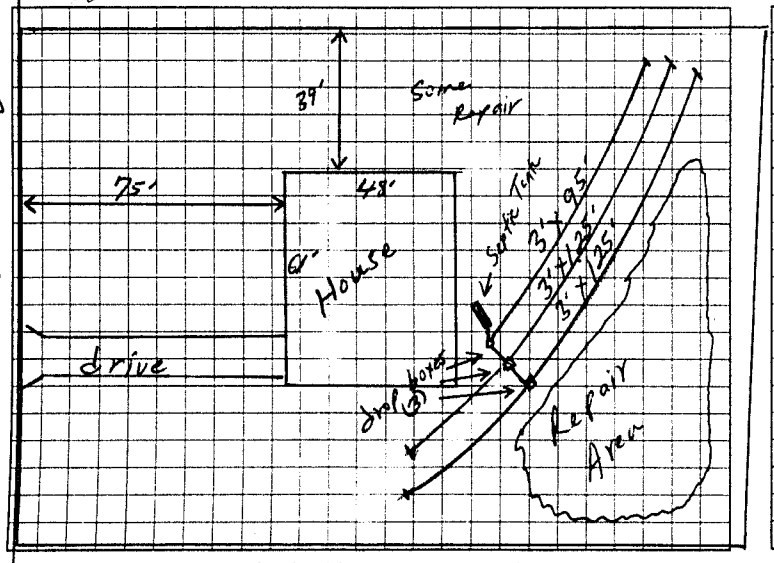

AS BUILT SKETCH

Rimmer Road (Quick Loop)

Permit can be suspended or revoked if any false information is supplied toward securing the permit; any unauthorized changes are made to the site; any unauthorized changes are made in the installation of the system. Improvement Permit with plat valid without expiration. Improvement Permit with site plan valid for sixty months. Authorization to Construct is valid for a period equal to that of Improvement Permit – not to exceed sixty months.

Signed: [signature] agent. date 2/13/02 Installed by: CRAIG THOMPSON

Improvement Permit by: [signature] date 2/13/02 Operation Permit by: [signature] RS date 02-10-02

Authorization to Construct by: [signature] date 2/13/02 Existing System Inspection by: date

HEALTH DEPT COPY WHITE OWNER COPY (FINAL) YELLOW OWNER COPY (INITIAL) PINK