IREDELL COUNTY HEALTH DEPARTMENT

STATESVILLE 704-878-5305 MOORESVILLE 704-664-5281

IMPROVEMENT PERMIT / AUTHORIZATION TO CONSTRUCT / OPERATION PERMIT / EXISTING SYSTEM INSPECTION

PERMIT# 90201 PIN# 4746321167 DATE June 27 2000

OWNER OR CONTRACTOR DAVIS Builders PHONE: Business 312 1301 Home

ADDRESS 122 Grayson PARK Rd STATESville

LOCATION Hwy 21 N @ Rimmer THRU 4 WAY STRAIGHT ZURich LOT on LEFT

SUBDIVISION FAIRVIEW FARM BLOCK / SECTION LOT 33 LOT AREA .68 SITE CLASS PS DESIGN FLOW 480 L.T.A.R. .4

Septic Tank: 1000 Gallons; STB 1009 Date 6-6-00
Pump Tank: Gallons; PT Date
Pump Make: Model Serial No.
Nitrification Field: No Fields 1 Square Feet 1200 Linear Feet 300
No Lines 5 Trench Width 36" Max Trench Bottom Depth 36" Gravel Depth N/A

☑ New System ☐ Repair System Type: I, II, III, IV, V, VI
System Description: GRAVITY 25% Reduction
Repair System Description: GRAVITY 25-50% Red
Maintenance Agreement Required: ☐ Yes ☑ No Pump
☐ Slab ☑ Crawl Space ☐ Basement w/plumbing ☐ Basement wo/plumbing


☑ House/Mod. Home No. Bedrooms 4
☐ Mobile Home No. Bathrooms 2
☐ Business No. Employees
☐ Other

Water Supply: ☐ Individual ☑ Public ☐ Community


Comments/Conditions: INSTALL on CONTOUR 50 CHAMBERS OR 30 HDS sections.

Comments/Conditions: *Note Due to lay of land start of lines deep last 3 lines Hit line of rock trim system

INITIAL SITE SKETCH

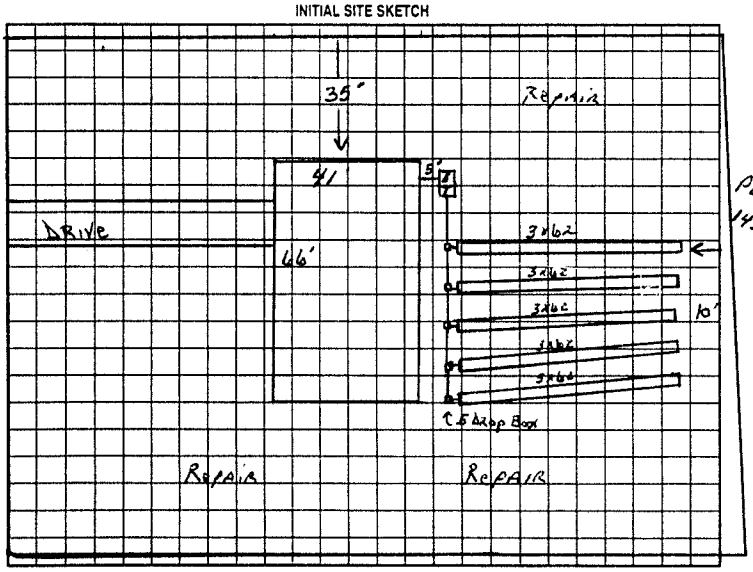

AS BUILT SKETCH

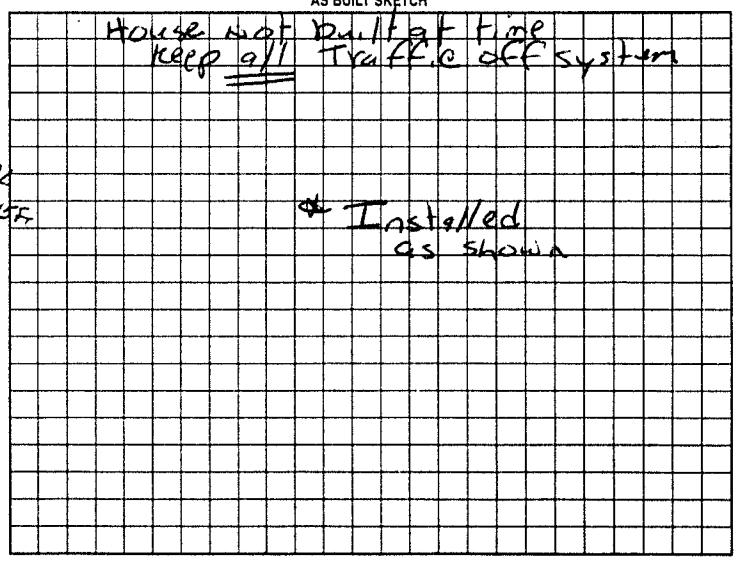

Permit can be suspended or revoked if any false information is supplied toward securing the permit/any unauthorized changes are made to the site/any unauthorized changes are made in the installation of the system. Improvement Permit with plat valid without expiration. Improvement Permit with site plan valid for sixty months. Authorization to Construct is valid for a period equal to that of Improvement Permit – not to exceed sixty months.

Signed: Jonathan Scott Davis date 7-7-00 Installed by: J+J Backhoe

Improvement Permit by: JC Potter date June 27 2000 Operation Permit by: [signature] date 8-3-00

Authorization to Construct by: JC Potter date June 27 2000 Existing System Inspection by: date

HEALTH DEPT. COPY: WHITE OWNER COPY (FINAL): YELLOW OWNER COPY (INITIAL): PINK