IREDELL COUNTY HEALTH DEPARTMENT

STATESVILLE 704-878-5305 MOORESVILLE 704-664-5281

IMPROVEMENT PERMIT / AUTHORIZATION TO CONSTRUCT / OPERATION PERMIT / EXISTING SYSTEM INSPECTION

PERMIT# 82609 PIN# DATE 1-26-00

OWNER OR CONTRACTOR Steve Dagenhart PHONE: Business 873.6211 Home

ADDRESS PO Box 1613 Statesville, N.C.

LOCATION Turnersburg Hwy TL Rimmer on rt after Fairgate

SUBDIVISION Fairview Fms BLOCK SECTION LOT 13 LOT AREA .9 acres SITE CLASS PS DESIGN FLOW 360 L.T.A.R. .13

Septic Tank: 1000 Gallons; STB 1000 Date 9-7-00
Pump Tank: Gallons; PT Date
Pump Make: Model Serial No.
Nitrification Field: No Fields 1 Square Feet 1200 Linear Feet 400
No Lines 5 Trench Width 36" Max Trench Bottom Depth 36" Gravel Depth 12"

☑ New System ☐ Repair System Type: I II III IV V VI
System Description: conv. Gravity
Repair System Description: " "
Maintenance Agreement Required: ☐ Yes ☐ No


☑ House/Mod Home No. Bedrooms 3
☐ Mobile Home No. Bathrooms 2
☐ Business No. Employees
☐ Other
☐ Slab ☑ Crawl Space ☑ Basement w/plumbing ☐ Basement wo/plumbing

Water Supply: ☐ Individual ☑ Public ☐ Community

Comments/Conditions:

Comments/Conditions: SEPTIC TANK WITH MARKER INSTALLED USING "PolyLok" FILTER

INITIAL SITE SKETCH 315.30'

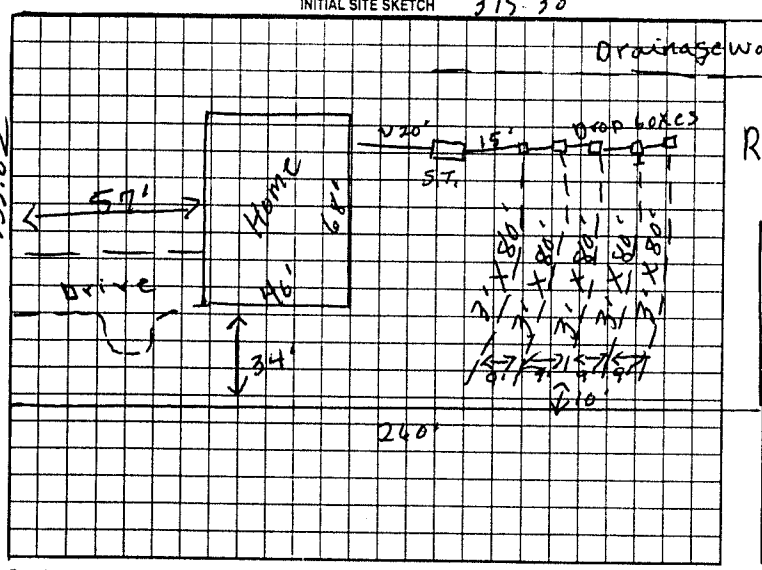

AS BUILT SKETCH

SYSTEM INSTALLED ACCORDING TO INITAL SITE SKETCH

Permit can be suspended or revoked if any false information is supplied toward securing the permit/any unauthorized changes are made to the site/any unauthorized changes are made in the installation of the system. Improvement Permit with plat valid without expiration. Improvement Permit with site plan valid for sixty months. Authorization to Construct is valid for a period equal to that of Improvement Permit – not to exceed sixty months.

Signed: X Doug Simon date

Improvement Permit by: P.C. Moore date 1-26-00

Authorization to Construct by: P.C. Moore date 1-26-00

Installed by: JAMES HUDLER

Operation Permit by: STEVE HEDRICK date 12-18-00

Existing System Inspection by: date

HEALTH DEPT. COPY: WHITE OWNER COPY (FINAL): YELLOW OWNER COPY (INITIAL): PINK