IREDELL COUNTY HEALTH DEPARTMENT

STATESVILLE 704-878-5305 CI MOORESVILLE 704-664-5281

IMPROVEMENT PERMIT / AUTHORIZATION TO CONSTRUCT / OPERATION PERMIT / EXISTING SYSTEM INSPECTION

PERMIT# 106549 PIN# 4746-32-6492 DATE 6-6-02

OWNER OR CONTRACTOR PILOT BUILDERS PHONE: Business 704-202-4964 Home

ADDRESS 450 AUCTION DRIVE, SALISBURY NC 28147

LOCATION US 21 NORTH TL RIMMER ROAD, TR FAIRGATE DRIVE, 2ND LOT ON LEFT

SUBDIVISION FAIRVIEW FARMS BLOCK / SECTION LOT 11 LOT AREA 0.6060 ACRE SITE CLASS PS DESIGN FLOW 360 L.T.A.R. 0.30 GPD/FT²

Septic Tank: 1000 Gallons: STB Date

Pump Tank: Gallons: PT Date

Pump Make: Model Serial No.

Nitrification Field: No Fields 1 Square Feet 1200 Linear Feet 400

No Lines FIVE Trench Width 36" Max Trench Bottom Depth 36" Gravel Depth 12"

☒ New System ☐ Repair System Type: I ☒ II III IV V VI

System Description: CONVENTIONAL, GRAVITY

Repair System Description: CONVENTIONAL, PUMP

Maintenance Agreement Required: ☐ Yes ☒ No

☒ House/Mod. Home ☐ Mobile Home ☐ Business ☐ Other

No. Bedrooms 3 No. Bathrooms 2 No. Employees


☐ Slab ☒ Crawl Space ☐ Basement w/plumbing ☐ Basement wo/plumbing

Water Supply: ☐ Individual ☒ Public ☐ Community


Comments/Conditions:

Comments/Conditions: - pot lok Filter Installed

INITIAL SITE SKETCH

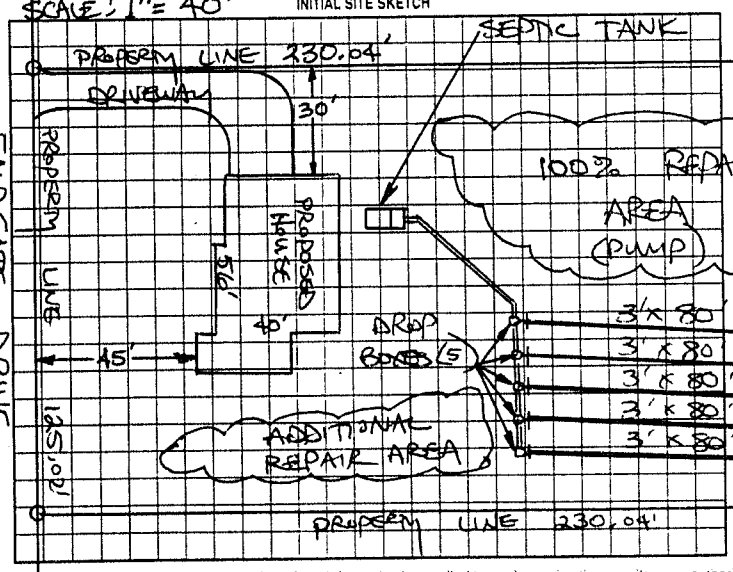

AS BUILT SKETCH

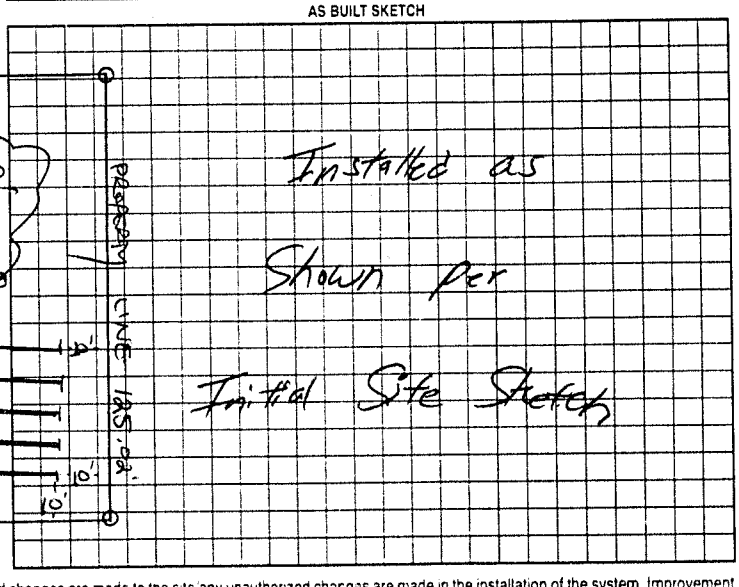

Permit can be suspended or revoked if any false information is supplied toward securing the permit; any unauthorized changes are made to the site; any unauthorized changes are made in the installation of the system. Improvement Permit with plat valid without expiration. Improvement Permit with site plan valid for sixty months. Authorization to Construct is valid for a period equal to that of Improvement Permit - not to exceed sixty months

Signed: _____ date 6/7/02 Installed by Rowan Septic

Improvement Permit by: STEVE HENDRICK date 6-6-02 Operation Permit by William O Johnson date 7-18-02

Authorization to Construct by: STEVE HENDRICK date 6-6-02 Existing System Inspection by: _____ date _____

HEALTH DEPT. COPY: WHITE OWNER COPY (FINAL): YELLOW OWNER COPY (INITIAL): PINK