11:00

IREDELL COUNTY HEALTH DEPARTMENT

STATESVILLE 704-878-5305 (CI) MOORESVILLE 704-664-5281

IMPROVEMENT PERMIT / AUTHORIZATION TO CONSTRUCT / OPERATION PERMIT / EXISTING SYSTEM INSPECTION

PERMIT# 134706 PIN# 4746326596 DATE 4-28-06

OWNER OR APPLICANT Graham F Knight PHONE: Business 704 363 2096 Home

ADDRESS 117 Fairgate

LOCATION Hwy 21 (N) (L) Rimmer Rd. (R) Fairgate - Lot on left

SUBDIVISION Fairview Farms BLOCK / SECTION LOT 109 LOT AREA .919 Acre SITE CLASS. PS DESIGN FLOW 360 L.T.A.R. .03

Septic Tank: 1000 Gallons; STB 825 Date 4-28-06

Pump Tank: Gallons; PT Date 7-11-06

Pump Make: Model Serial No.

Nitrification Field: No Fields 1 Square Feet 1200 Linear Feet 300

No Lines 3 Trench Width 36" Max Trench Bottom Depth 36" Gravel Depth

☒ New System ☐ Repair ☐ Expansion System Type: I (II) III IV V VI

System Description: 25% Reduction

Repair System Description: 50% Reduction LP

Maintenance Agreement Required: ☐ Yes ☐ No

☒ Gravity ☐ Pressure

☒ House/Mod. Home No. Bedrooms 3

☐ Mobile Home No. Persons

☐ Business No. Employees

☐ Other

Water Supply: ☒ Individual ☐ Public ☐ Community

☐ Slab ☐ Crawl Space ☐ Basement w/plumbing ☐ Basement wo/plumbing

Comments:/Conditions:


(3) × 3' = 100'

Comments:/Conditions:


Blue Tuf-Lite Infa

30" risers

INITIAL SITE SKETCH

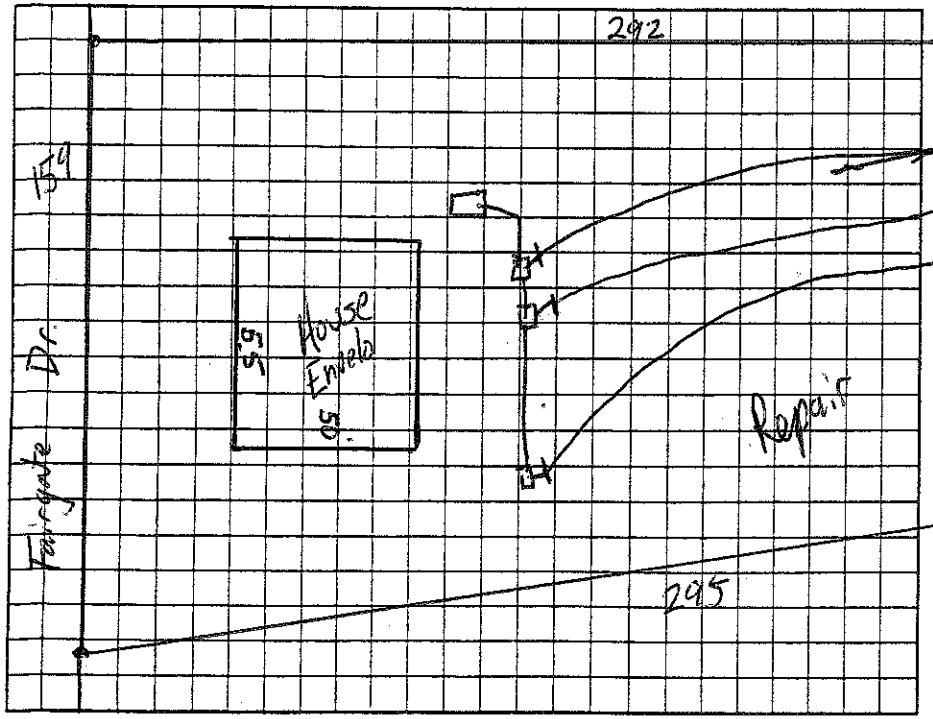

AS BUILT SKETCH

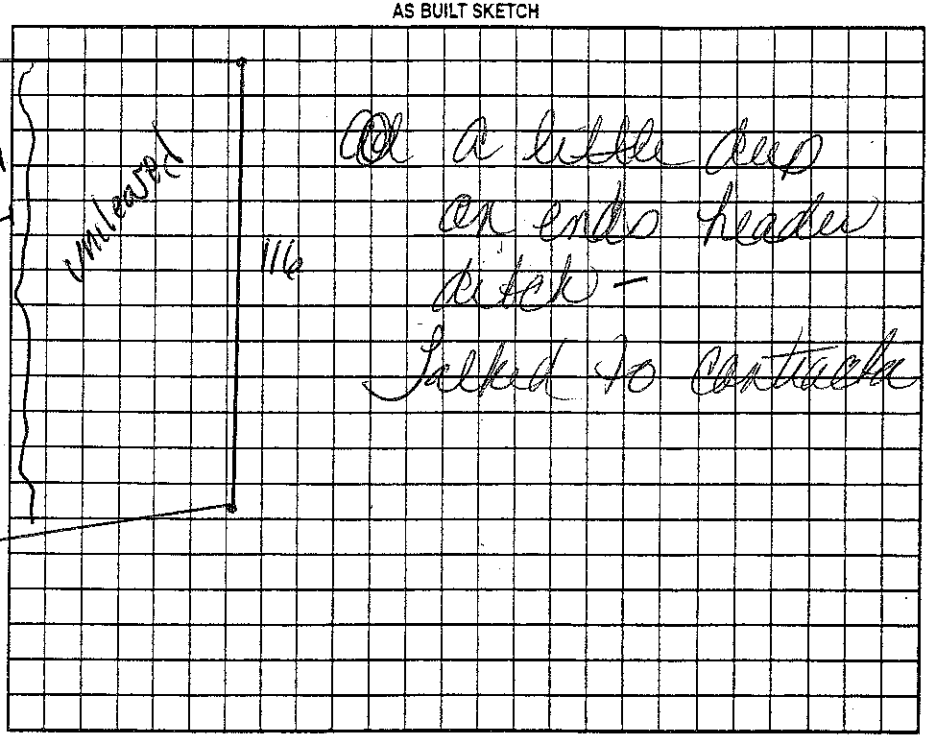

Permit can be suspended or revoked if any false information is supplied toward securing the permit/any unauthorized changes are made to the site/any unauthorized changes are made in the installation of the system. Improvement Permit with plat valid without expiration. ☐ Improvement Permit with site plan valid for sixty months ☐ Authorization to Construct is valid for a period equal to that of Improvement Permit – not to exceed sixty months.

Signed: Keith Knight date

Improvement Permit by: James Allen date 4-28-06

Authorization to Construct by: James Allen date 4-28-06

Installed by: Bailey Septic SVC

Operation Permit by: James Allen date 9/12/06

Existing System Inspection by date

HEALTH DEPT COPY: WHITE OWNER COPY (FINAL): YELLOW OWNER COPY (INITIAL): PINK