IREDELL COUNTY HEALTH DEPARTMENT

STATESVILLE 704-878-5305 MOORESVILLE 704-664-5281

IMPROVEMENT PERMIT / AUTHORIZATION TO CONSTRUCT / OPERATION PERMIT / EXISTING SYSTEM INSPECTION

PERMIT# 12491 PIN# 4746-32-7749 831 GARY AUSTIN DATE 11-20-04

OWNER OR CONTRACTOR AUSTIN & AUSTIN BLDG CO PHONE: Business 704-876-0105 Home

ADDRESS 120 CHECKERS LANE STATESVILLE, NC 28625

LOCATION 21 N ⓔ RIMMER RD ⓡ FAIRGATE DRIVE LAST LOT ON LEFT @ LOT # 7

SUBDIVISION FAIRVIEW FARMS BLOCK / SECTION LOT 17 LOT AREA .76 AC SITE CLASS PS DESIGN FLOW 360 L.T.A.R. .35

Septic Tank: 1000 Gallons; STB 1612 Date 2-9-05
Pump Tank: Gallons; PT Date
Pump Make: Model Serial No.
Nitrification Field: No Fields 1 Square Feet 1028 Linear Feet 345'
No Lines 5 Trench Width 36" Max Trench Bottom Depth 36" Gravel Depth 12"

☒ New System ☐ Repair System Type: I (II) III, IV, V, VI
System Description: CONV 60PAN
Repair System Description: SAME
Maintenance Agreement Required: ☐ Yes ☒ No

☒ House/Mod. Home No. Bedrooms 3
☐ Mobile Home No. Bathrooms 2
☐ Business No. Employees
☐ Other


☐ Slab ☒ Crawl Space ☐ Basement w/plumbing ☐ Basement wo/plumbing

Water Supply: ☐ Individual ☒ Public ☐ Community


Comments/Conditions: ① INSTALL LINES ON CONTOURS ② MAINTAIN SETBACKS ③ SMOOTH OUT CONTOURS WITHOUT EXCESSIVE CUTTING

Comments:/Conditions: TUFFTITE FILTER & MARKER
V'D 1ST 2 LINES & TANK
V'D LAST 3 LINES, OK IL
BLDR SHOWED ME P/L & LINES 10' OFF & SUPPLIES 5' OFF.

INITIAL SITE SKETCH 1" = 50'

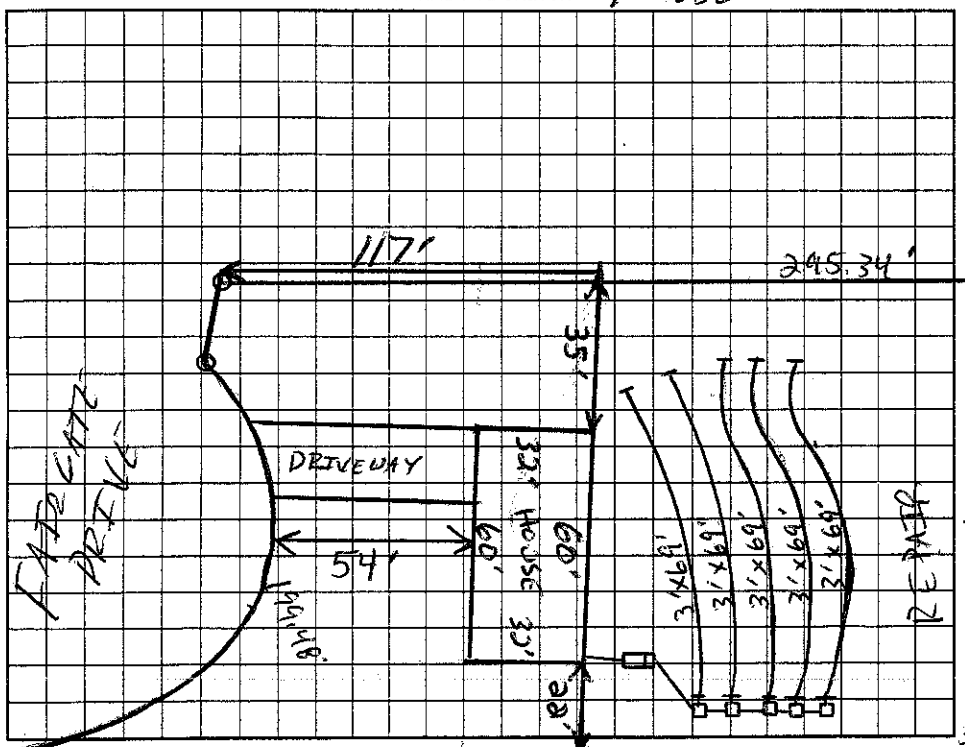

AS BUILT SKETCH

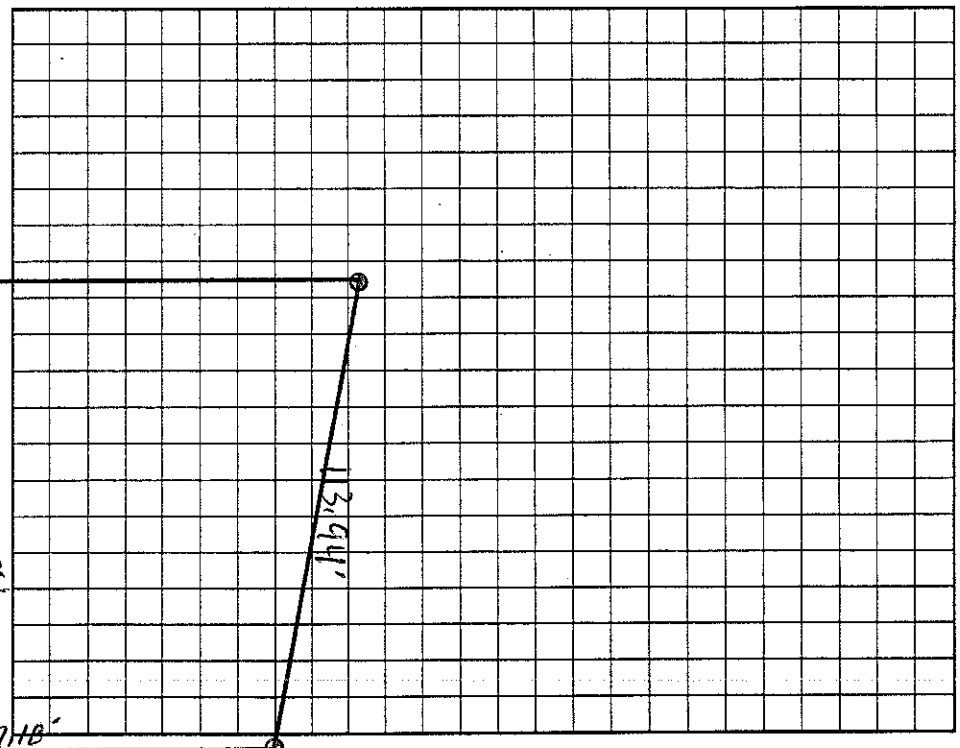

Permit can be suspended or revoked if any false information is supplied toward securing the permit/any unauthorized changes are made to the site/any unauthorized changes are made in the installation of the system. Improvement Permit with plat valid without expiration. Improvement Permit with site plan valid for sixty months. Authorization to Construct is valid for a period equal to that of Improvement Permit – not to exceed sixty months.

Signed: Gary R Austin date 11-20-04 Installed by: AUSTIN BLDRS SELF INSTALLED

Improvement Permit by: [signature] date 11-20-04 Operation Permit by: [signature] date 2-9-05

Authorization to Construct by: [signature] date 11-20-04 Existing System Inspection by: date

HEALTH DEPT. COPY: WHITE OWNER COPY (FINAL): YELLOW OWNER COPY (INITIAL): PINK