IREDELL COUNTY HEALTH DEPARTMENT

STATESVILLE 704-878-5305 MOORESVILLE 704-664-5281

IMPROVEMENT PERMIT / AUTHORIZATION TO CONSTRUCT / OPERATION PERMIT / EXISTING SYSTEM INSPECTION

PERMIT# 79233 PIN# 4746214848 DATE 2-12-99

OWNER OR CONTRACTOR C C & S INC. PHONE: Business 7049248635 Home

ADDRESS 218 W Broad St. Suite 2 Sta N.C.

LOCATION 21 N TL Rimmer TR Fairgate 2nd lot Rt.

SUBDIVISION Fairview BLOCK / SECTION LOT 2 LOT AREA .6 acres SITE CLASS PS DESIGN FLOW 360 L.T.A.R. .3

Septic Tank: 1000 Gallons; STB 1012 Date 3-28-99

Pump Tank: Gallons; PT Date

Pump Make: Model Serial No

Nitrification Field: No Fields 1 Square Feet 900 Linear Feet 300

No Lines 3 Trench Width 36" Max Trench Bottom Depth 36" Gravel Depth

New System / Repair System Type: I, II, III, IV, V, VI

System Description: Gravity 25% Red

Repair System Description: " 50% Red

Maintenance Agreement Required: Yes / No

Slab / Crawl Space / Basement w/plumbing / Basement wo/plumbing

House/Mod. Home / Mobile Home / Business / Other

No. Bedrooms 3 No. Bathrooms 2 No. Employees


Water Supply: Individual / Public / Community

Comments/Conditions:


Comments/Conditions

* Note: 2 line are slightly deeper

INITIAL SITE SKETCH

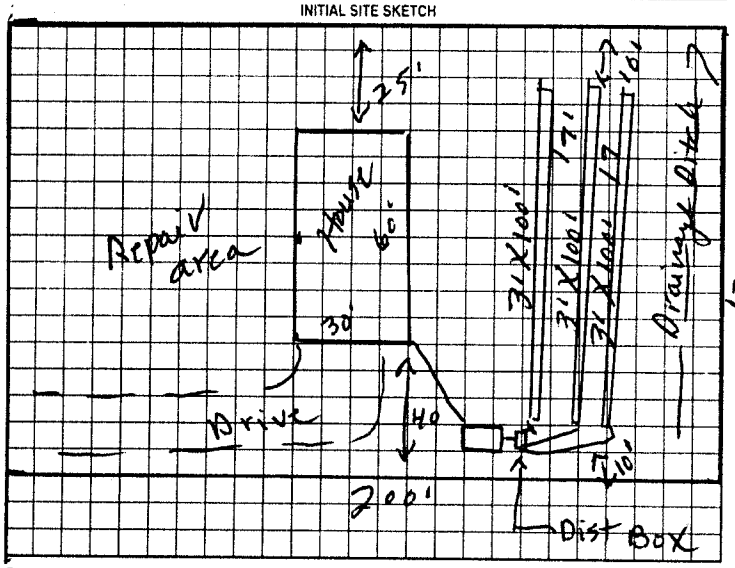

AS BUILT SKETCH

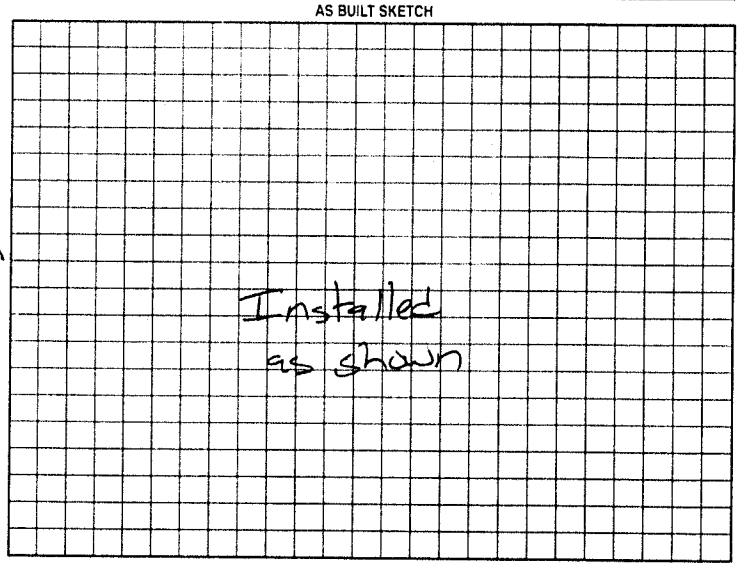

Permit can be suspended or revoked if any false information is supplied toward securing the permit/any unauthorized changes are made to the site/any unauthorized changes are made in the installation of the system. Improvement Permit with plat valid without expiration. Improvement Permit with site plan valid for sixty months. Authorization to Construct is valid for a period equal to that of Improvement Permit – not to exceed sixty months.

Signed: [signature] date 2/15/99 Installed by: A-1 Backhoe

Improvement Permit by: P. C. Moore date 2-12-99 Operation Permit by: Mark C. Owens BS date 2-21-99

Authorization to Construct by: P. C. Moore date 2-12-99 Existing System Inspection by: date

HEALTH DEPT. COPY WHITE OWNER COPY (FINAL) YELLOW OWNER COPY (INITIAL) PINK