IREDELL COUNTY HEALTH DEPARTMENT

Statesville Phone TR 3-7271 Mooresville Phone No. 664-5281

PERMIT TO INSTALL SEPTIC TANK

Permit No. Blder. Permit Date 5-22 1973

Owner Jenkins Bldr. Address Scotts N.C.

Installed By York Batty Address Stony Point, NC

Location of Property Iredell Heights -


N/W Corner - Victoria Dr & Debbie Lane

Tank		Capacity		Length of Lines		Fixtures	
Block	( )	1000	(✓)	225'	( )	No. of Baths	(1½)
Precast	(✓)	1250	( )	250'	( )	Dishwasher	( )
		1500	( )	Other 240 720 Sq Ft		Garbage Grdr.	( )
		Other				Other	

NOTIFY HEALTH DEPARTMENT AT LEAST EIGHT HOURS BEFORE TANK IS TO BE INSPECTED.

Final Inspection 6-5-73 Approved (✓) Disapproved ( )

Remarks Iredell Water Corp.

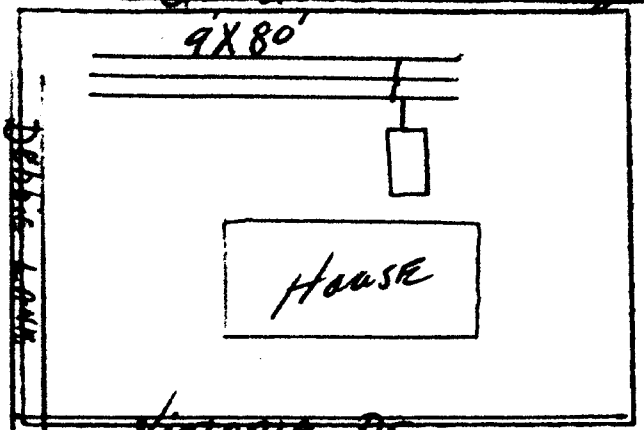

Sketch of Installation

Sanitarian