IREDELL COUNTY HEALTH DEPARTMENT

Statesville Phone TR 3-7271 Mooresville Phone NO 3-1271

PERMIT TO INSTALL SEPTIC TANK

Permit No. 172 Permit Date 9-28 1972

Owner Hope Bros. Builders Inc Address Statesville, N.C.

Installed By Hope Bros. Address Statesville, NC


Location of Property Iredell Heights - Debbie Lane - Lot #45

Tank		Capacity		Length of Lines		Fixtures	
Block	( )	1000	(✓)	225'	(✓)	No. of Baths	(✓)
Precast	(✓)	1250	( )	250'	( )	Dishwasher	( )
		1500	( )	Other		Garbage Grdr.	( )
		Other				Other	

NOTIFY HEALTH DEPARTMENT AT LEAST EIGHT HOURS BEFORE TANK IS TO BE INSPECTED.

Final Inspection 9-28 1972 Approved (✓) Disapproved ( )

Remarks Iredell Water Corp.

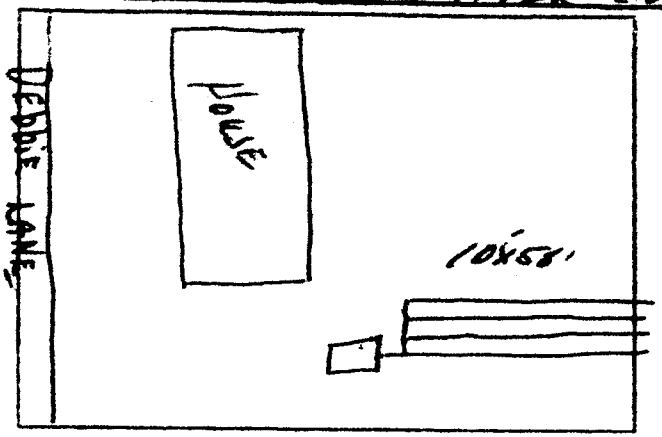

Sketch of Installation

Clay type soil

Sanitarian