IREDELL COUNTY HEALTH DEPARTMENT

Statesville Phone TR 3-7271 Mooresville Phone No. 664-5281

PERMIT TO INSTALL SEPTIC TANK

Permit No. 24 Permit Date 10-26 1972

Owner BLDR. FLAKE PRATT JAMES LILES - Address STATESVILLE, NC.

Installed By RAYMOND ADAMS Address HIDDENITE, N.C.

Location of Property IREDELL HEIGHTS

DEBBIE LANE -

LOT #. 34-35-36-37-38-39


Tank		Capacity		Length of Lines		Fixtures	
Block	( )	1000	(✓)	225'	( )	No. of Baths	(2)
Precast	(✓)	1250	( )	250'	( )	Dishwasher	( )
		1500	( )	Other 240		Garbage Grdr.	( )
		Other				Other	

NOTIFY HEALTH DEPARTMENT AT LEAST EIGHT HOURS BEFORE TANK IS TO BE INSPECTED.

Final Inspection 10-26 1972 Approved (✓) Disapprcved ( )

Remarks

WATER SUPPLY - IREDELL WATER CORP.

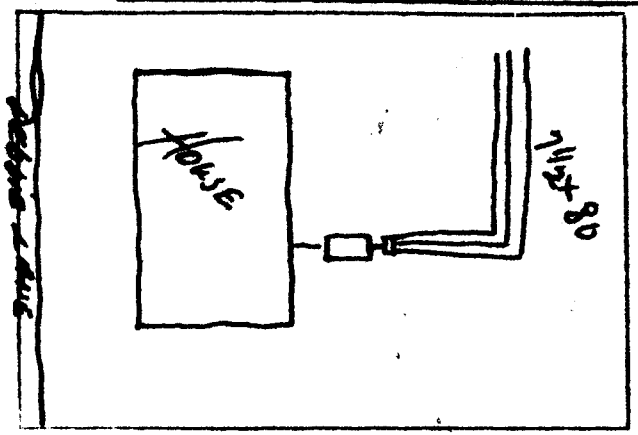

Sketch of Installation

Sanitarian