IREDELL COUNTY HEALTH DEPARTMENT

Statesville Phone TR 3-7271 — Mooresville Phone No. 664-5281

PERMIT TO INSTALL SEPTIC TANK

Permit No. [illegible] Permit Date 5-22 1973

Owner Bld. JENKIN Bldrs. Address STATESVILLE, NC

Installed By HERMAN GIBSON Address STATESVILLE, NC


Location of Property IREDELL HEIGHTS — From DEBBIE LANE 2nd House on LEFT — Victoria Dr.

Tank		Capacity		Length of Lines		Fixtures	
Block	( )	1000	(✓)	225'	( )	No. of Baths	(1½)
Precast	(✓)	1250	( )	250'	( )	Dishwasher	( )
		1500	( )	Other 300		Garbage Grdr.	( )
		Other				Other	

NOTIFY HEALTH DEPARTMENT AT LEAST EIGHT HOURS BEFORE TANK IS TO BE INSPECTED.

Final Inspection _____ 19__ Approved (✓) Disapproved ( )

Remarks IREDELL WATER CORP.

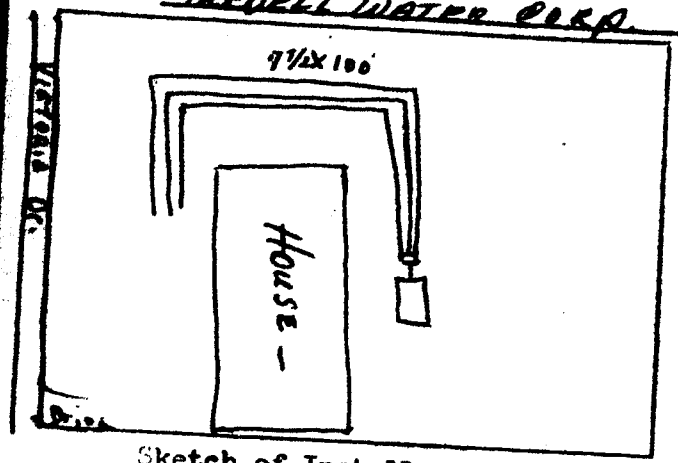

Sketch of Installation

Glenn Fox
Sanitarian