IREDELL COUNTY HEALTH DEPARTMENT

Statesville Phone TR 3-7271 Mooresville Phone No. 664-5281

PERMIT TO INSTALL SEPTIC TANK

Permit No. _____ Permit Date 4-13 1973

Owner Bldr- JENKINS Bldrs. Address [redacted], NC

Installed By Herman Gibson Address STATESVILLE, NC.


Location of Property 21 N- IREDELL HEIGHTS — S/W Corner Victoria Dr. & DEVON LANE

Tank		Capacity		Length of Lines		Fixtures	
Block	( )	1000	(✓)	225'	( )	No. of Baths	(1½)
Precast	(✓)	1250	( )	250'	( )	Dishwasher	(✓)
		1500	( )	Other 240		Garbage Grdr.	( )
		Other _____				Other _____	

NOTIFY HEALTH DEPARTMENT AT LEAST EIGHT HOURS BEFORE TANK IS TO BE INSPECTED.

Final Inspection 4-13 1973 Approved (✓) Disapproved ( )

Remarks Iredell Water Corp

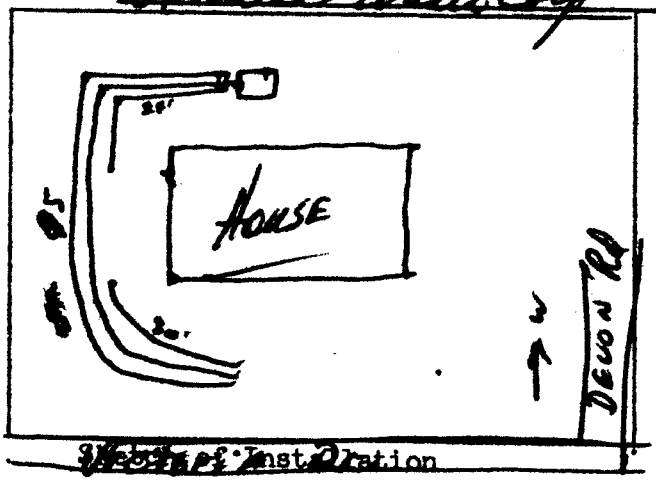

Sketch of Installation

Glenn T. [illegible] Jr.
Sanitarian