IREDELL COUNTY HEALTH DEPARTMENT

Statesville Phone TR 3-7271 Mooresville Phone NO 3-1271

PERMIT TO INSTALL SEPTIC TANK

Permit No. 118 Permit Date Dec 21 1972

Owner Bill McAllister Address 623 Cherry St. Statesville, N. C.

Installed By Leonard Evans Address

Location of Property Trades Heights - Victoria Dr.


Lot 161 - 164

Tank		Capacity		Length of Lines		Fixtures	
Block	( )	1000	(✓)	225'	( )	No. of Baths	( )
Precast	(✓)	1250	(●)	250'	( )	Dishwasher	(✓)
		1500	( )	Other 240'		Garbage Grdr.	( )
		Other				Other	

NOTIFY HEALTH DEPARTMENT AT LEAST EIGHT HOURS BEFORE TANK IS TO BE INSPECTED.

Final Inspection Dec 20 1972 Approved (✓) Disapproved ( )

Remarks

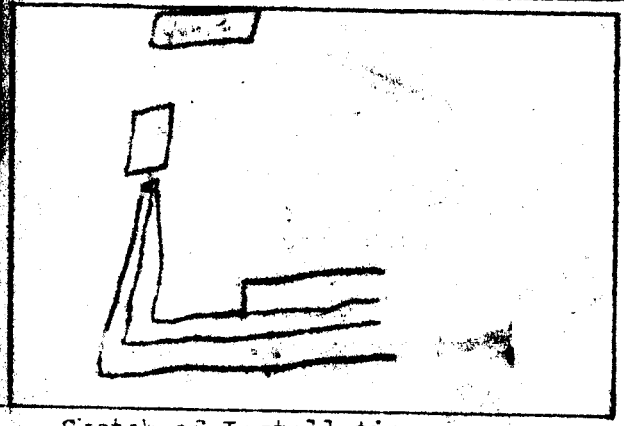

Sketch of Installation

William M. Howard

Sanitarian