IREDELL COUNTY HEALTH DEPARTMENT

STATESVILLE 704-878-5305 MOORESVILLE 704-664-5281

IMPROVEMENT PERMIT / AUTHORIZATION TO CONSTRUCT / OPERATION PERMIT / EXISTING SYSTEM INSPECTION

PERMIT# REPAIR PIN# 4746 35 2263 DATE 3-15-02

OWNER OR CONTRACTOR FERN V. SIMMERSON PHONE: Business Home 704-876-0117

ADDRESS 114 VICTORIA DRIVE, STATESVILLE, NC 28625-8921

LOCATION US 21 N, TL SAWMAKER DR, TL W, DEBBIE LANE, TR VICTORIA DR, 3RD LOT ON RIGHT

SUBDIVISION IREDELL HEIGHTS BLOCK / SECTION LOT 193-197 LOT AREA 125' x 192' SITE CLASS PS DESIGN FLOW 360 L.T.A.R. EXISTING

Septic Tank: 1000 Gallons: STB Date
Pump Tank: Gallons; PT Date
Pump Make: Model Serial No.
Nitrification Field: No Fields 1 Square Feet Linear Feet EXISTING
No Lines Trench Width Max Trench Bottom Depth Gravel Depth

☐ New System ☒ Repair System Type: I (II) III. IV. V. VI
System Description: CONVENTIONAL GRAVITY
Repair System Description: CONV., GRAVITY
Maintenance Agreement Required: ☐ Yes ☒ No
☐ Slab ☐ Crawl Space ☐ Basement w/plumbing ☐ Basement wo/plumbing


☒ House/Mod. Home No. Bedrooms 3
☐ Mobile Home No. Bathrooms 2
☐ Business No. Employees
☐ Other

Water Supply:
☐ Individual
☒ Public
☐ Community


Comments/Conditions: INSTALL NEW SEPTIC TANK AT LOCATION SHOWN

Comments/Conditions: SEPTIC TANK WITH RISERS AND MARKER INSTALLED USING "PolyLok" FILTER

INITIAL SITE SKETCH

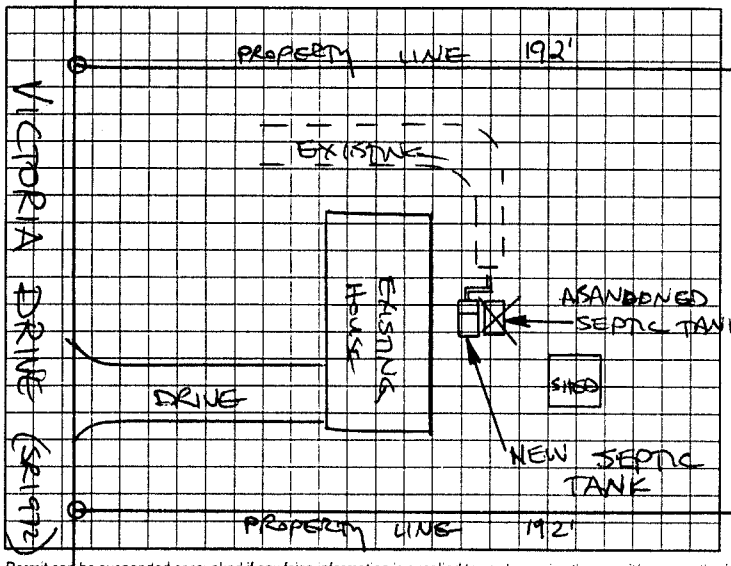

AS BUILT SKETCH

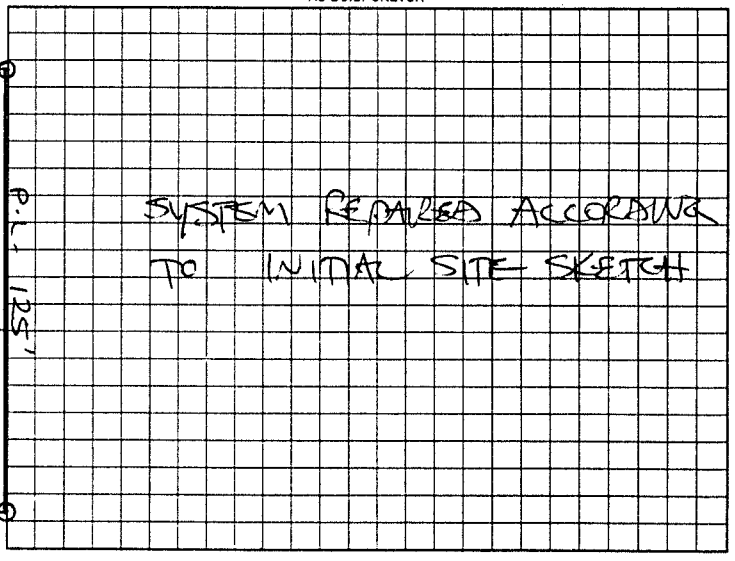

Permit can be suspended or revoked if any false information is supplied toward securing the permit/any unauthorized changes are made to the site/any unauthorized changes are made in the installation of the system. Improvement Permit with plat valid without expiration. Improvement Permit with site plan valid for sixty months. Authorization to Construct is valid for a period equal to that of Improvement Permit – not to exceed sixty months.

Signed: [signature] date 3-15-02 Installed by: PIEDMONT BACKHOE

Improvement Permit by: STEVE HEDRICK date 3-15-02 Operation Permit by: STEVE HEDRICK date 3-15-02

Authorization to Construct by: STEVE HEDRICK date 3-15-02 Existing System Inspection by: date

HEALTH DEPT. COPY: WHITE OWNER COPY (FINAL): YELLOW OWNER COPY (INITIAL): PINK