IREDELL COUNTY HEALTH DEPARTMENT

STATESVILLE 704-878-5305 MOORESVILLE 704-664-5281

IMPROVEMENT PERMIT / CERTIFICATE OF COMPLETION / OPERATION PERMIT / EXISTING SYSTEM INSPECTION

PROPERTY DESCRIPTION NO. _____ DATE 2-27-97 TAX MAP NO. _____ Watershed: ☐ Yes ☐ No

OWNER OR CONTRACTOR Pat Clodfelter PHONE: Business 873-0512 Home _____

ADDRESS 120 Victoria Drive

LOCATION 21N TL Sidemaker Th w. Debbie TR Victoria Drive 3rd Hse RT

SUBDIVISION Iredell Heights BLOCK / SECTION _____ LOT _____ LOT AREA 100'X200' SITE CLASS. _____ DESIGN FLOW _____ L.T.A.R. _____

Septic Tank: Ex1 Gallons; STB _____ Date _____

Pump Tank: 1000 Gallons; PT 24 Date 4-15-97

Pump Make: Hydromatic Model SK50A1 Serial No. 516540107

Nitrification Field: No Fields 2 Square Feet 654 Linear Feet 228

No Lines 3 Trench Width 36" Max Trench Bottom Depth 36" Gravel Depth N/A

☐ New System ☐ Repair System Type: I, II, III, IV, V, VI

System Description: _____

Repair System Description: Pump To Chamber

Maintenance Agreement Required: ☐ Yes ☐ No

☐ House/Mod. Home No. Bedrooms 3

☐ Mobile Home No. Bathrooms 2

☐ Business No. Employees ____

☐ Other _____


☐ Slab ☐ Crawl Space ☐ Basement w/plumbing ☐ Basement wo/plumbing

Water Supply: ☐ Individual ☐ Community ☐ Public


Comments:

Comments:

INITIAL SITE SKETCH

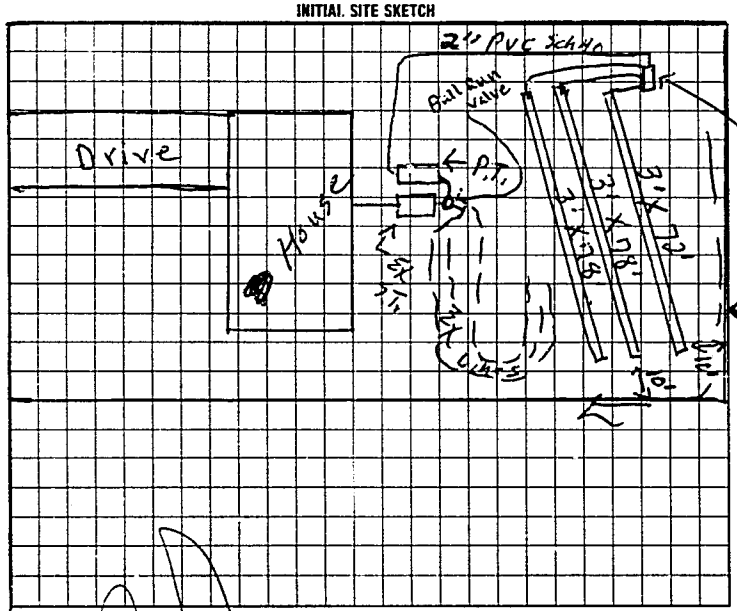

AS BUILT SKETCH

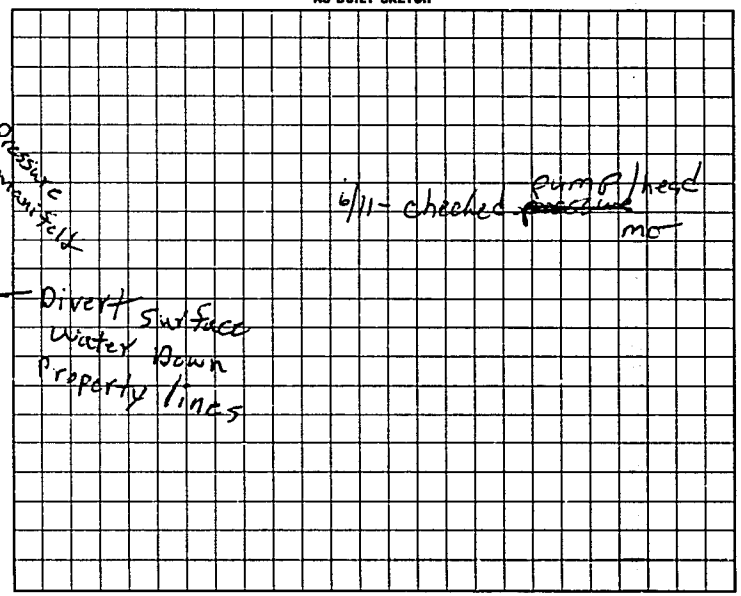

I understand that this permit can be suspended or revoked if any false information is supplied toward securing the permit/any unauthorized changes are made to the site/any unauthorized changes are made in the installation of the system. Improvement Permit is valid for 60 months from date of issuance.

Signed: _____ Installed by: James Huddler

Improvement Permit by: P.C. Moore date 2-27-97 Certificate of Completion by: _____ date _____

Existing System Inspection by: P.C. Moore date 2-27-97 Operation Permit by: _____ date 6-24-97

Authorization to Connect

HEALTH DEPT. COPY: WHITE INSPECTION COPY (FINAL): GREEN OWNER COPY (FINAL): YELLOW INSPECTION COPY (INITIAL): PINK OWNER COPY (INITIAL): GOLD

Authorization to Connect Expires 60 mos from issue