IREDELL COUNTY HEALTH DEPARTMENT

Statesville Office (704) 878-5305 Mooresville Office (704) 660-3625 PERMIT # 178088

IMPROVEMENT PERMIT / AUTHORIZATION TO CONSTRUCT / OPERATION PERMIT / EXISTING SYSTEM

PIN # 4746357464

APPLICANT: Johnny Welborn APPLICANT ADDRESS: 124 Victoria Dr

SITE ADDRESS: 124 Victoria Dr. PHONE: 704-876-3871 ALT. PHONE: N/A


SITE DIRECTIONS: Hwy 21 N TL Shumaker Dr TL Debbie Ln TR Victoria Ln.

SUBDIVISION: Iredell Heights SECTION: N/A LOT # 185-188 LOT AREA: 0.43 acres DESIGN FLOW: 360 gpd L.T.A.R.: 0.3

Septic Tank	Existing (gal)	STB	Date	☐ New System ☑ Repair ☐ Expansion	System Type: I II (III) IV V VI	☑ Residence	No. Bedrooms 3	Water Supply
Pump Tank	(gal)	PT	Date	System Description:		☐ Business	No. Persons	☐ Private
Pump Make	Model		Serial #	Repair System Description: 25% Reduction		☐ Other	No. Employees	☑ Public
# Nitrification Fields 1	# Lines 5		Linear Ft: 200 220	Maintenance Agreement Required:	☐ YES ☑ NO	☐ Slab	☐ Crawl Space	☐ Community
Trench Width 36"	Max. Trench Bottom Depth 36"		Gravel Depth N/A	☑ GRAVITY	☐ PRESSURE	☐ Basement w/plumbing		☑ Basement w/o plumbing

Comments / Conditions: Install a 25% Reduction system on contour with serial distribution. Replace septic tank and/or tee if necessary.

INITIAL SITE SKETCH

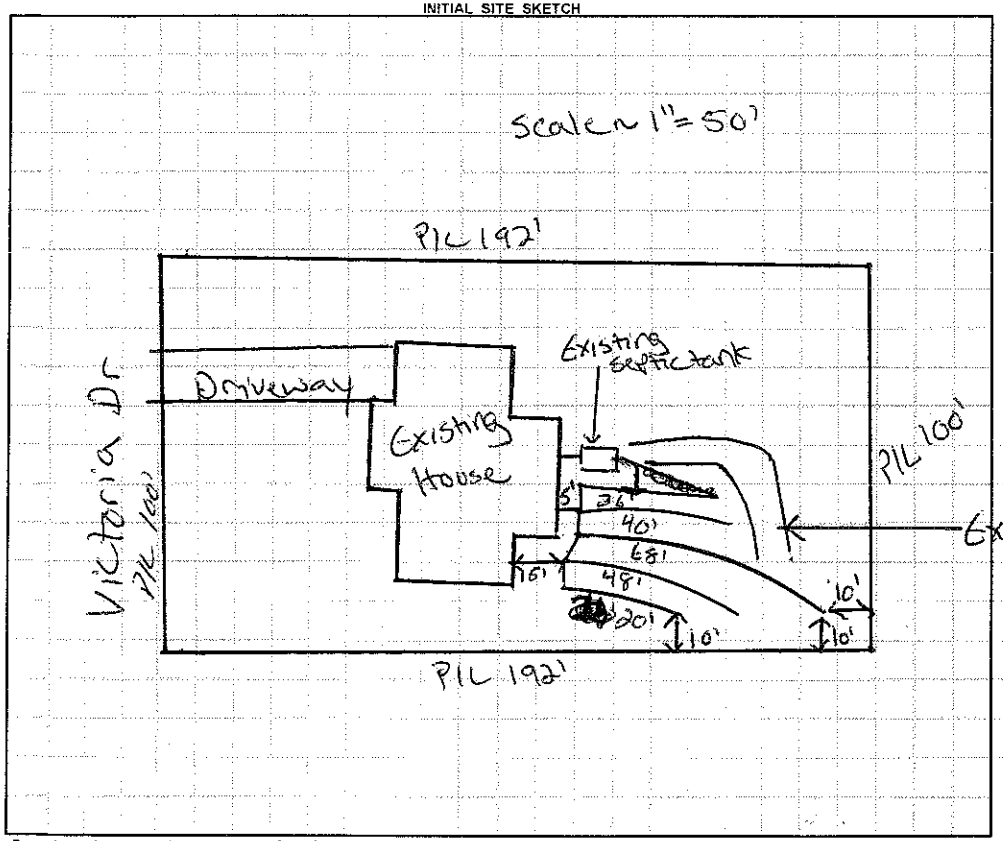

AS BUILT SKETCH

- Quick 4 Chambers installed
- Installed as drawn
- Top Line is center fed.

Permit can be suspended or revoked if any false information is supplied toward securing the permit / any unauthorized changes are made to the site / any unauthorized changes are made in the installation of the system. **CONTACT A LOCATOR SERVICE PRIOR TO ANY EXCAVATION**

☐ **IMPROVEMENT PERMIT** *with plat valid without expiration.* ☑ **IMPROVEMENT PERMIT** *with site plan valid for 60 mos.* ☑ **AUTHORIZATION TO CONSTRUCT** *valid for period equal to IMPROVEMENT PERMIT--not to exceed 60 mo.*

Owner / Applicant Signature: Johnny B. Welborn Date: 5-1-13 Installed by: Steve Jordan

IMPROVEMENT PERMIT by: Justin Henderson Date: 5-1-13 OPERATION PERMIT by: Justin Henderson Date: 5-3-13

AUTHORIZATION TO CONSTRUCT by: Justin Henderson Date: 5-1-13 Existing System Inspected by: Date:

Health Dept. Copy - WHITE Applicant (Final Approval) - YELLOW Applicant (Conditional Approval) - PINK