IREDELL COUNTY HEALTH DEPARTMENT

STATESVILLE 704-878-5305 MOORESVILLE 704-664-5281

IMPROVEMENT PERMIT / AUTHORIZATION TO CONSTRUCT / OPERATION PERMIT / EXISTING SYSTEM INSPECTION

PERMIT# REPAIR PIN# 4746 35 2655 DATE 9-11-02

OWNER OR CONTRACTOR DEAN A. LAIL PHONE: Business 704-878-5043 Home

ADDRESS 134 VICTORIA DRIVE, STATESVILLE NC 28625-8921

LOCATION US 21 NORTH TL SHUMAKER RD, TL W. DEBBIE LANE, TR VICTORIA DR, HOUSE ON RIGHT AT #134

SUBDIVISION REDELL HEIGHTS BLOCK / SECTION LOT 177-180 LOT AREA 100' x 192' SITE CLASS. PS DESIGN FLOW 360 L.T.A.R. EXISTING

Septic Tank: ~~EXISTING~~ Gallons: ST8 1072 Date 12-31-9

Pump Tank: 1000 Gallons: PT Date

Pump Make: Model Serial No.

Nitrification Field: No Fields 1 Square Feet ~~EXIST~~ 400 Linear Feet 133

No Lines TWO Trench Width 24" Max Trench Bottom Depth Gravel Depth N/A

~~New System~~ Repair System Type: I, II, III, V, V, VI

System Description:

Repair System Description: CHAMBERS, GRAVITY

Maintenance Agreement Required: ☐ Yes ☒ No

☑ House/Mod. Home No. Bedrooms 3

☐ Mobile Home No. Bathrooms 2½

☐ Business No. Employees

☐ Other


☐ Slab ☐ Crawl Space ☐ Basement w/plumbing ☑ Basement w/o plumbing

Water Supply: ☐ Individual ☒ Public ☐ Community


Comments/Conditions: INSTALL 2' CHAMBER (SUCH AS "INFILTRATOR - EQUALIZER 36") IN TWO TRENCHES AS SHOWN - 16 CHAMBERS TOTAL AT 84' EACH

Comments/Conditions: SEPTIC TANK WITH MARKER INSTALLED USING "POLY LOK" FILTER

INITIAL SITE SKETCH

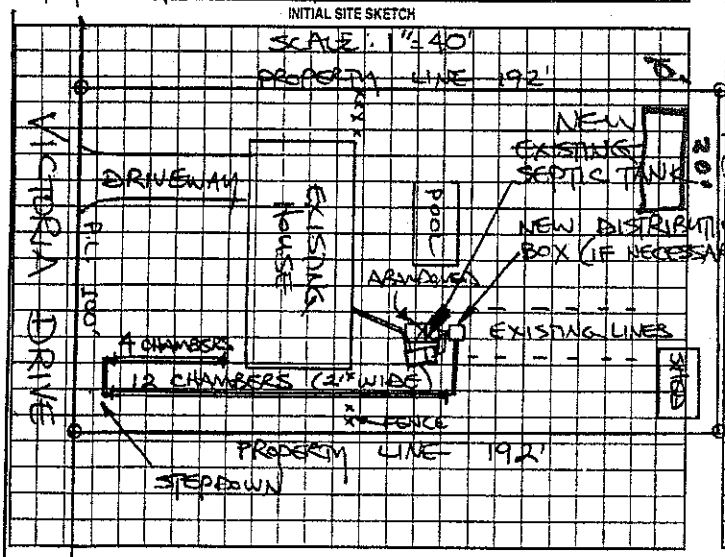

AS BUILT SKETCH

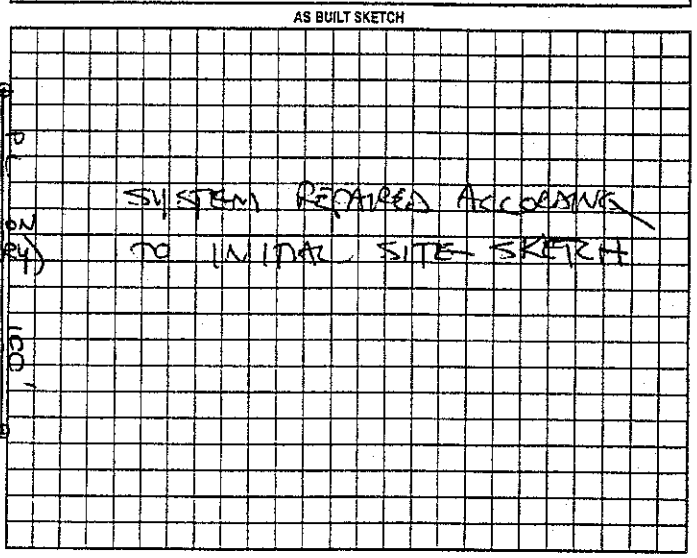

Permit can be suspended or revoked if any false information is supplied toward securing the permit/any unauthorized changes are made to the site/any unauthorized changes are made in the installation of the system. Improvement Permit with plat valid without expiration. Improvement Permit with site plan valid for sixty months. Authorization to Construct is valid for a period equal to that of Improvement Permit – not to exceed sixty months.

Signed: [signature] date 2-11-02 Installed by: PIEDMONT BACKHOE

Improvement Permit by: STEVE HEDRICK date 2-11-02 Operation Permit by: STEVE HEDRICK date 2-22-02

Authorization to Construct by: STEVE HEDRICK date 2-11-02 Existing System Inspection by: date

HEALTH DEPT. COPY: WHITE OWNER COPY (FINAL) YELLOW OWNER COPY (INITIAL) PINK

Location of the proposed Storage Building addition does not appear to impact the existing on-site septic system.**NOTE:

[signature] REHS

Date: 11-21-11

ICHD-Environmental Health Division