ICHD - ENVIRONMENTAL HEALTH DIVISION

Statesville Office (704) 878-5305 DW Mooresville Office (704) 660-3625 PERMIT # AP 321181

SEPTIC: IMPROVEMENT PERMIT / AUTHORIZATION TO CONSTRUCT / OPERATION PERMIT / EXISTING SYSTEM

PIN # 4746 -- 35 -- 4068

APPLICANT/OWNER: J Edwin Hunter APPLICANT ADDRESS: 735 St Andrews Rd, Statesville

SITE ADDRESS: 232 W Edison Dr Statesville 28625 PHONE: 704-880-3494 ALT. PHONE –


SITE DIRECTIONS: Hwy 21 N - Lt Shumaker Rd - Lt W Edison Dr SAP CONTROLLED: [X] YES [ ] NO

SUBDIVISION: Iredell Heights SECTION: – LOT # 212-215 LOT AREA: 0.49 acres DESIGN FLOW: 360 L.T.A.R.: Existing

Septic Tank	1000	(gal)	STB	Infiltrator	Date	Plastic	[ ] New System	[X] Repair	[ ] Expansion	System Type: I II (III) IV V VI	[X] Residence	No. Bedrooms	3	Water Supply
Pump Tank		(gal)	PT		Date		System Description:	Existing			[ ] Business	No. Persons	6	[ ] Private
Pump Make			Model		Serial #		Repair System Description:	Tank Replacement			[ ] Other	No. Employees		[X] Public
# Nitrification Fields			# Lines		Linear Ft:		Maintenance Agreement Required:	[ ] YES	[X] NO		[ ] Slab	[X] Crawl Space		[ ] Community
Trench Width	EXISTING		Trench Bottom Depth(Low side)		Gravel Depth		[X] GRAVITY	[ ] PRESSURE			[ ] Basement w/plumbing			[ ] Basement w/o plumbing

Comments / Conditions: Pump, crush and fill cracked tank., Replace distribution devices if necessary. Feed lines equally.

INITIAL SITE SKETCH

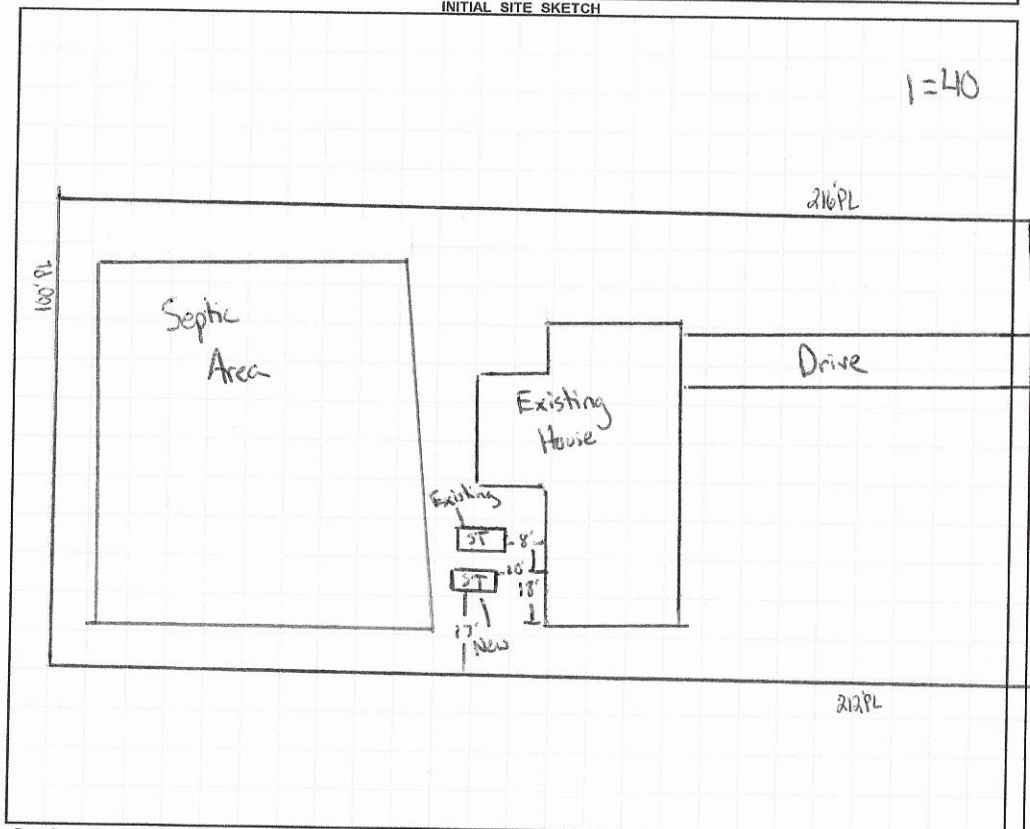

AS BUILT SKETCH

FOR SEPTIC FINAL INSPECTION CALL: 704-664-3703 between 8am-9am the day the inspection is needed. Be sure to speak with an inspector to confirm your time.

Installed as Drawn

Permit can be suspended or revoked if any false information is supplied toward securing the permit / any unauthorized changes are made to the site / any unauthorized changes are made in the installation of the system. **CONTACT A LOCATOR SERVICE PRIOR TO ANY EXCAVATION**

[ ] **IMPROVEMENT PERMIT** *with plat valid without expiration.* [X] **IMPROVEMENT PERMIT** *with site plan valid for 60 mos.* [X] **AUTHORIZATION TO CONSTRUCT** *valid for period equal to IMPROVEMENT PERMIT--not to exceed 60 mo.*

Owner / Applicant Signature: J Edwin Hunter Date: 9/10/21 Installed by: Lentz Wastewater

IMPROVEMENT PERMIT by: Cory Whitt Date: 9/9/21 OPERATION PERMIT by: Date: 10-4-2021

AUTHORIZATION TO CONSTRUCT by: Cory Whitt Date: 9/9/21 Existing System Inspected by: Date:

FOR SEPTIC FINAL INSPECTION: CALL 704-664-3703 between 8am-9am the day the inspection is needed.

RECEIVED SEP 3 - 2021

AP 321181

APPLICATION MUST BE FILLED OUT COMPLETELY & BE LEGIBLE OR IT WILL NOT BE PROCESSED For Evaluation-

Iredell County Health Department – Environmental Health Division

PAGE 1: *APPLICATION FORM*

Paid $150.00

Application For: ( ) New Well Permit ( ) Well Repair Permit ( ) Well Abandonment
( ) Septic Improvement Permit ( ) Authorization to Construct ( ) Existing System Inspection (X) Septic System Repair

THE ABOVE PERMIT DOCUMENTS WILL BECOME INVALID IF INFORMATION PROVIDED ON THIS APPLICATION IS FALSIFIED OR CHANGED, OR IF THE SITE IS ALTERED. THE IMPROVEMENT PERMIT IS VALID FOR EITHER 60 MONTHS OR WITHOUT EXPIRATION DEPENDING UPON DOCUMENTATION SUBMITTED. APPLICATION WITH SITE PLAN 60 MONTHS, APPLICATION WITH COMPLETE, SCALED PLAT WITHOUT EXPIRATION. SEE 15A NCAC 18A .1937(f) FOR DETAILS.

Page 2: *Site Plan Worksheet* form MUST accompany this application

The following optional attachments may also be submitted: ( ) Survey Plat, scaled no more than 1 inch = 60 feet
Place an (X) beside whichever is submitted if applicable ( ) Custom Site Plan, scaled no more than 1 inch = 60 feet

Applicant Information: (PRINT CLEARLY)

Applicant Name: J. Edwin Hunter Address: 725 ST Andrews Rd Statesville Zip: 28625

Applicant Email: _____ Phone: 7048803494 Alt. Phone: _____

Owner Name: J. Edwin Hunter Address: 725 St. Andrews Rd Statesville Zip: 28625

Owner Email: _____ Phone: _____ Alt. Phone: _____

Property Information:

Street Address: 232 W Edison Dr, Statesville NC 28625

Subdivision Name: Iredell Heights Section/Phase: _____ Lot Number: _____

Driving Directions: Turnersburg Rd, Left on Slurmabee Road, Left on Edison Drive - House on right Second From End of Street

Site Development Information: *(check or complete ALL that apply*

CHECK FOUNDATION TYPE

( ) New Single Family Residence Maximum Number of Bedrooms: 3 (X) Crawl Space Foundation
( ) New Multi-Family Residence Maximum Number of Occupants: _____ ( ) Concrete Slab Foundation
( ) Accessory Building ( ) Swimming Pool ( ) Basement with Plumbing
( ) Bedroom(s) Addition ( ) Other Addition/Structure: _____ ( ) Basement without Plumbing
(X) Repair to failing septic system X Tank ___ Drain lines Describe Problem: crack in Tank
Non-Residential Site Development: Type of Business: _____
Square Footage of Building: _____ Max. Number of Employees: _____ Max. Number of Seats/Beds/Other: _____

Water Supply: ( ) Replacement Well – Reason: _____
( ) Multi-connection Well Number of Houses: _____ Number of Persons: _____

( ) New Well ( ) Existing Well ( ) Community Well (X) City Water ( ) Other Public Water

Desired Septic System Type: *(you may rank in order of preference)* Year existing system installed: 1973
( ) No Preference ( ) Alternative (X) Conventional ( ) Innovative ( ) Modified Conventional ( ) Other: _____

Please answer the following to the best of your ability:

( ) Yes (X) No Does the site contain any jurisdictional wetlands?
( ) Yes (X) No Is any non-domestic sewage (i.e. industrial) to be generated?
( ) Yes (X) No Is the site subject to approval by any other public agency?

I have read this application and certify that the information provided herein is true, complete, and correct. Authorized county and state officials are granted right of entry to conduct necessary inspections to determine compliance with applicable laws and rules. I understand that I am solely responsible for the proper identification and labeling of all property lines and corners and making the site accessible so that a complete site evaluation can be performed.

Signature: J. Edwin Hunter 9/2/21
Property owner or owner's legal representative signature (SIGNATURE REQUIRED) DATE

IREDELL COUNTY DEPARTMENT OF ENVIRONMENTAL HEALTH

DOCUMENTATION TO AUTHORIZE AN OWNER'S LEGAL REPRESENTATIVE

(Check and sign only ONE of the options below)

☐ **1. * APPLICANT AND OWNER ARE THE SAME. *** (*Sign here*) J Edwin Hunter

Applications for permits require the "signature of the owner or owner's legal representative" (15A NCAC 18A .1937). If the owner does not sign the application himself or herself, they can submit any one of the following documents to designate their legal representative: *Power of Attorney; Real Estate Contract; Estate executor; Bankruptcy trustee; Court ordered guardianship* In the absence of the above documentation, the property owner may provide the local health department with documentation that designates a legal representative. A property owner may:
Complete this form to document his or her legal representative, or provide his or her own form that contains the information in this form. If there are multiple property owners, then all property owners must sign the form that designates a legal representative.
By signing a form that designates a legal representative for purposes of 15A NCAC 18A .1937, the property owner authorizes that representative to act on their behalf in matters pertaining to the application and permitting process, including signing or receiving any application, document or permit. The owner retains full responsibility to meet all permit conditions specified by the local health department.

☐ **2.** I, J. Edwin Hunter, am the legal owner(s) of the property located at 232 West Edwin Dr, identified as PIN (Parcel Identification Number) 4746 35 4068 located in Iredell County, North Carolina.

I do hereby authorize (**print legal representative/company name**) _____,

_____, to act as an agent on my behalf in applying for/signing/obtaining any of the documents described below.

- Application for Improvement Permit (IP) / Authorization to Construct (AC)
- Improvement Permit (IP) / Authorization to Construct (AC)
- Application for soil-site evaluation (new/repair)
- Application/permit for private drinking water well/well abandonment
- Application for Compliance Inspection

I agree to abide by all decisions and/or conditions between the legal representative acting on my behalf and the Iredell County Department of Public Health, Environmental Health Division.

J Edwin Hunter
Signature of Owner(s)

9/2/21
Date

Mooresville - Environmental Health

Fax: 704-662-3239
610 E. Center Avenue, Mooresville, NC 28115


Statesville - Environmental Health
ronda.hart@co.iredell.nc.us
Fax: 704-871-3483
349 N. Center Street, Statesville, NC 28677

IREDELL COUNTY HEALTH DEPARTMENT

ENVIRONMENTAL HEALTH DIVISION

PAGE 2: *SITE PLAN WORKSHEET*

SEE THE "SAMPLE SITE PLAN" BELOW. *INCOMPLETE SITE PLANS WILL BE RETURNED TO YOU FOR COMPLETION AND MAY RESULT IN A DELAY IN THE ISSUANCE OF YOUR SEPTIC SYSTEM PERMIT!!!*

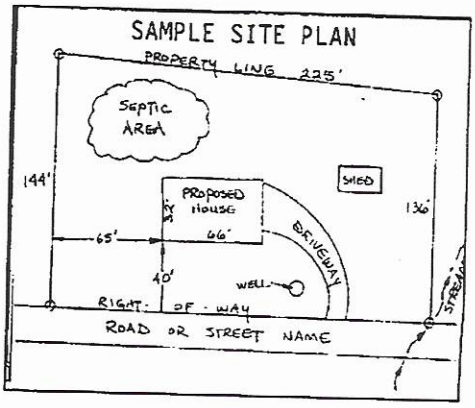

Place an (X) beside each item as you complete the site plan:


( ) Property Line measurements are clearly identified
( ) All proposed structures are indicated
( ) Front and side setbacks from property line
( ) Preferred driveway location and well location
( ) Area you prefer your septic system to be placed
( ) North arrow, or other sufficient indicator of direction

Circle N/A on the following if appropriate:

Location of septic systems and wells within 100' of your property	N/A
Location of easements and rights of ways on your property	N/A
Location of any designated wetlands on the property	N/A

USE THIS SPACE TO DRAW YOUR SITE PLAN

Show: proposed house or business footprint, wells, water lines, patios, pools and decks, and any other item that will occupy space on the site

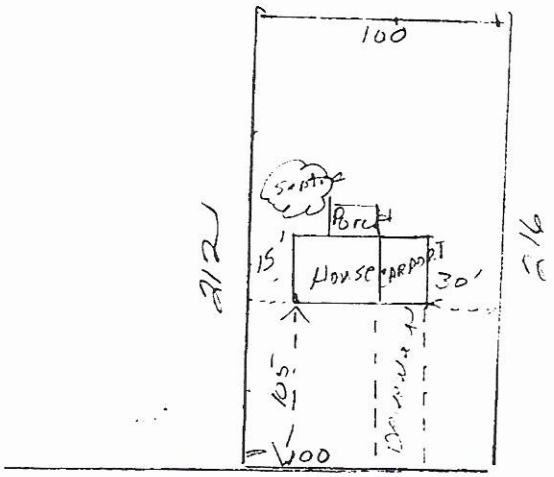

232 W. Edison

Signature: J. Elvin Hunter

Property owner or owner's legal representative signature (SIGNATURE REQUIRED)

9/2/21
DATE

IREDELL COUNTY HEALTH DEPARTMENT

STATESVILLE 704-878-5305 MOORESVILLE 704-664-5281

IMPROVEMENT PERMIT / AUTHORIZATION TO CONSTRUCT / OPERATION PERMIT / EXISTING SYSTEM INSPECTION

PERMIT# REPAIR PIN# 4746-35-4068 DATE 3-23-05

OWNER OR CONTRACTOR J. EDWIN HUNTER PHONE: Business 704-872-5800 Home 704-880-3494

ADDRESS 725 ST. ANDREWS RD, STATESVILLE, NC 28625

LOCATION US 21 N, TL SIMMAKER RD, TL W. EDISON DR, HOUSE ON RIGHT AT #232

SUBDIVISION IREDELL HEIGHTS BLOCK / SECTION ____ LOT 212-215 LOT AREA 100' X 212' SITE CLASS. PS DESIGN FLOW 360 L.T.A.R. EXISTING

Septic Tank: EXISTING Gallons: STB ____ Date ____

Pump Tank: ____ Gallons: PT ____ Date ____

Pump Make: ____ Model ____ Serial No. ____

Nitrification Field: No Fields 1 Square Feet 450 Linear Feet 150

No Lines TWO Trench Width 36" Max Trench Bottom Depth 36" Gravel Depth 12"

☒ New System ☒ Repair System Type: ☐ I ☐ II ☐ III, IV, V, VI

System Description: CONVENTIONAL, GRAVITY

Repair System Description: CONV, GRAVITY

Maintenance Agreement Required: ☐ Yes ☒ No

☒ House/Mod. Home No. Bedrooms 3

☐ Mobile Home No. Bathrooms ____

☐ Business No. Employees ____

☐ Other ____


☐ Slab ☒ Crawl Space ☐ Basement w/plumbing ☐ Basement wo/plumbing

Water Supply: ☐ Individual ☒ Public ☐ Community


Comments:/Conditions: INTERCEPT EXISTING DRAINLINE AT LOCATION SHOWN WITH NEW DROP BOX FEEDING TWO NEW 3' X 75' LINES

Comments:/Conditions:

INITIAL SITE SKETCH SCALE: 1" = 40'

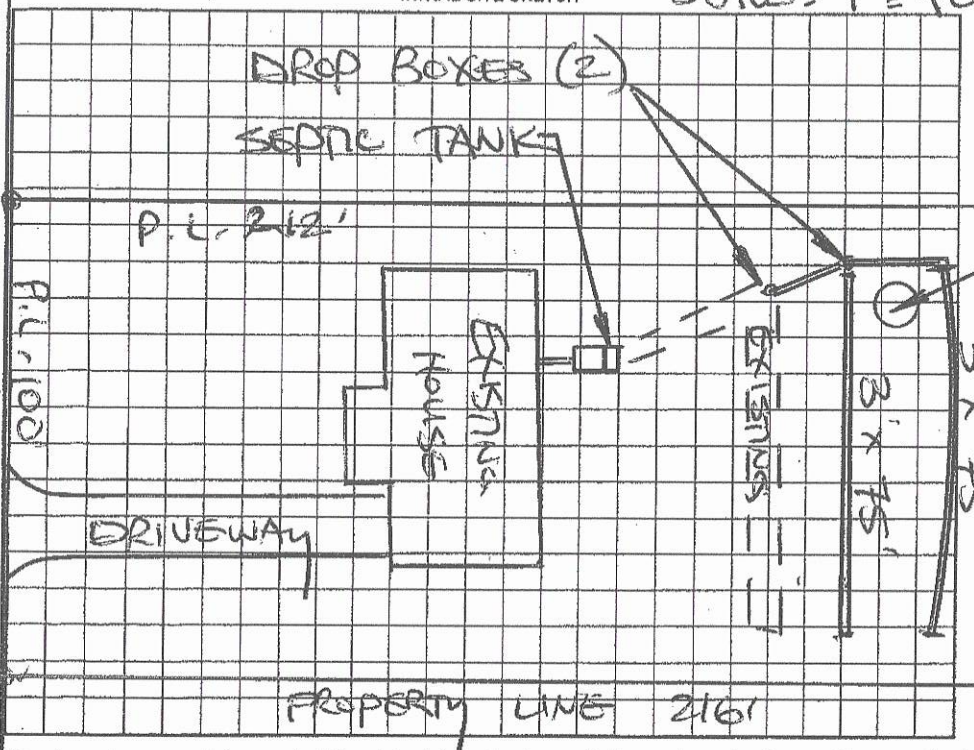

AS BUILT SKETCH

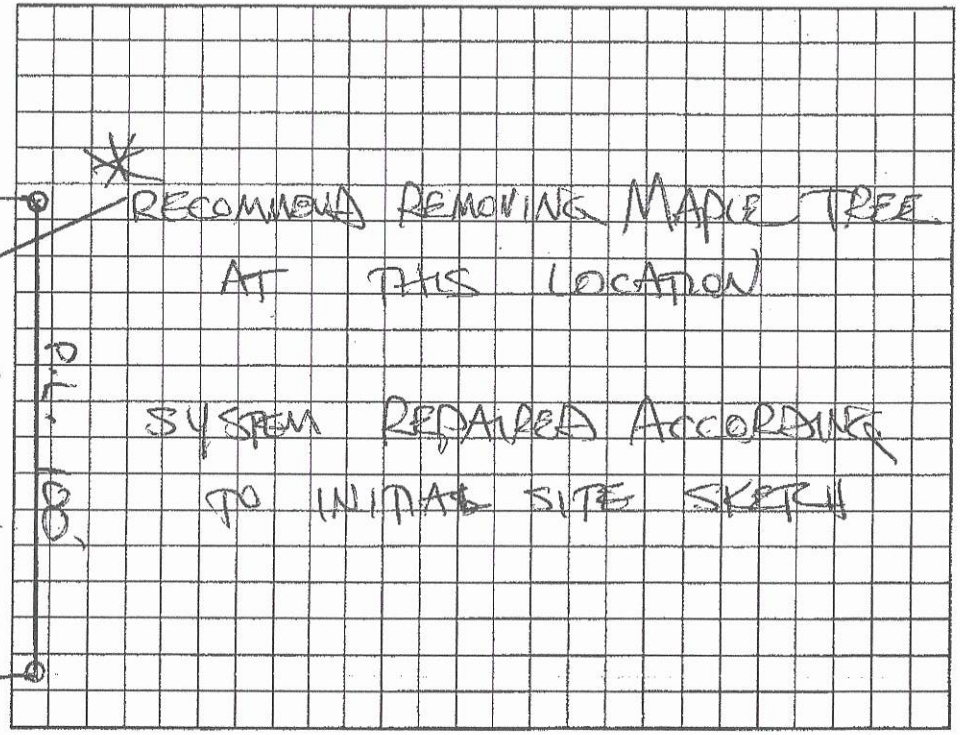

Permit can be suspended or revoked if any false information is supplied toward securing the permit/any unauthorized changes are made to the site/any unauthorized changes are made in the installation of the system. Improvement Permit with plat valid without expiration. Improvement Permit with site plan valid for sixty months. Authorization to Construct is valid for a period equal to that of Improvement Permit – not to exceed sixty months.

Signed: J. Edwin Hunter date 3/23/05 Installed by: WES LYTON

Improvement Permit by: STEVE HEDRICK date 3-23-05 Operation Permit by: STEVE HEDRICK date 4-20-05

Authorization to Construct by: STEVE HEDRICK date 3-23-05 Existing System Inspection by: ____ date ____

HEALTH DEPT. COPY: WHITE OWNER COPY (FINAL): YELLOW OWNER COPY (INITIAL): PINK

(10/98) 1" REG. ENGL. 3 PHASE / 25