IREDELL COUNTY HEALTH DEPARTMENT

Statesville Phone TR 3-7271 Mooresville Phone NO 3-1271

PERMIT TO INSTALL SEPTIC TANK

Permit No. 20 Permit Date 7-27 19 72

Bldr. CARL M. WHITE -

Owner PAUL MUNDAY Address STATESVILLE, N.C.

Installed By YORK Rufty Address Stony Point, NC


Location of Property 21 N - LEFT ON Rd # 1922 SHOEMAKER DR. TURN LEFT ON EIDSON DR. 1ST house on Rt.

Tank		Capacity		Length of Lines		Fixtures	
Block	( )	1000	(✓)	225'	( )	No. of Baths	(1½)
Precast	(✓)	1250	( )	250'	( )	Dishwasher	(1)
		1500	( )	Other 252		Garbage Grdr.	( )
		Other				Other	

NOTIFY HEALTH DEPARTMENT AT LEAST EIGHT HOURS BEFORE TANK IS TO BE INSPECTED.

Final Inspection 7-27 1972 Approved (✓) Disapproved ( )

Remarks IREDELL WATER Dept.

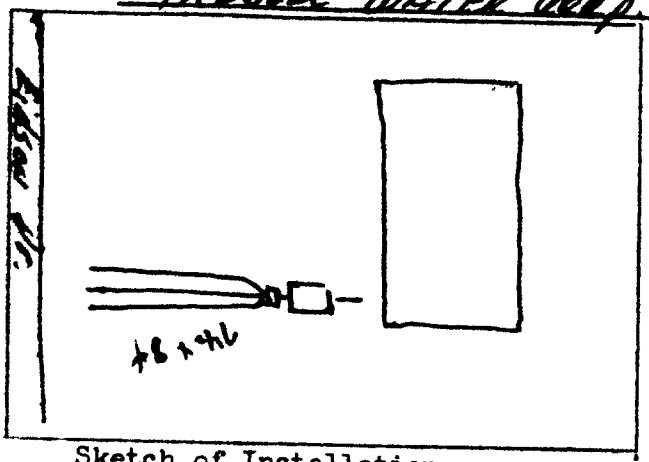

Sketch of Installation

Glenn Taylor

Sanitarian