IREDELL COUNTY HEALTH DEPARTMENT

Statesville Phone TR 3-7271 — Mooresville Phone NO 3-1271

PERMIT TO INSTALL SEPTIC TANK

Permit No. 203 — Permit Date MARCH 23 1971

Owner HOPE BROS BUILDERS INC — Address STATESVILLE, NC

Installed By ADAMS SEPTIC TANK SERV — Address TAYLORSV. LLE, NC

Location of Property IREDELL HEIGHTS


LOT NO. 484

Tank		Capacity		Length of Lines		Fixtures	
Block	( )	1000	(✓)	225'	( )	No. of Baths	(4)
Precast	( )	1250	( )	250'	( )	Dishwasher	( )
		1500	( )	Other 300 90Z SYX		Garbage Grdr.	( )
		Other				Other	

NOTIFY HEALTH DEPARTMENT AT LEAST EIGHT HOURS BEFORE TANK IS TO BE INSPECTED.

Final Inspection MARCH 23 1971 — Approved (✓) Disapproved ( )

Remarks IREDELL WATER CORP

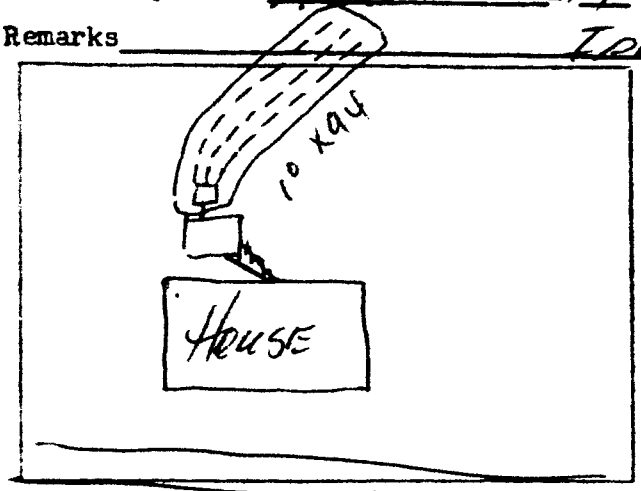

Sketch of Installation

Sanitarian