IREDELL COUNTY HEALTH DEPARTMENT

Statesville Phone TR 3-7271 Mooresville Phone NO 3-1271

PERMIT TO INSTALL SEPTIC TANK

Permit NO. 300 Permit Date Sept. 1 1970

Owner Hope Bros. Builders Inc Address Statesville, NC.

Installed By Adams Septic Tank Service Address Taylorsville, NC.


Location of Property Highway 21 North - Iredell Heights - Lot No. 474

Tank		Capacity		Length of Lines		Fixtures	
Block	( )	1000	(✓)	225'	( )	No. of Baths	(1½)
Precast	(✓)	1250	( )	250'	( )	Dishwasher	( )
		1500	( )	Other 300 - Straight Fill		Garbage Grdr.	( )
		Other				Other	

NOTIFY HEALTH DEPARTMENT AT LEAST EIGHT HOURS BEFORE TANK IS TO BE INSPECTED.

Final Inspection Sept. 1 1970 Approved (✓) Disapproved ( )

Remarks WATER SUPPLY - (IREDELL WATER CORP.)

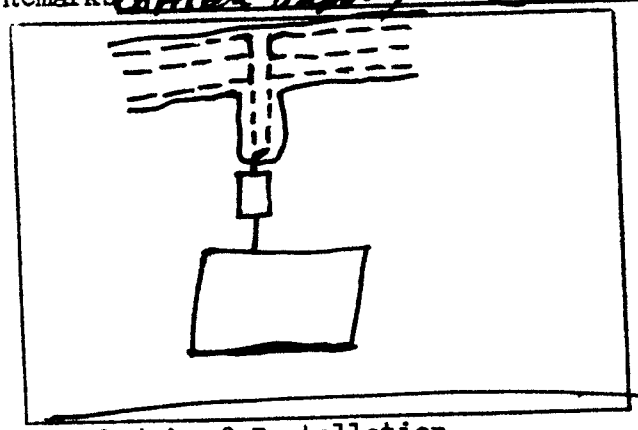

Sketch of Installation

Sanitarian