432

IREDELL COUNTY HEALTH DEPARTMENT

Statesville Phone TR 3-7271 Mooresville Phone NO 3-1271

PERMIT TO INSTALL SEPTIC TANK

Permit No. 362 Permit Date _____ 19__

Owner Hope Brothers Address Statesville

Installed By Lackey Brothers Address Stony Point

Location of Property Iredell Heights Lot # 432


Main road. House on left going out

Tank		Capacity		Length of Lines		Fixtures	
Block	( )	1000	(✓)	225'	( )	No. of Baths	(4½)
Precast	(✓)	1250	( )	250'	( )	Dishwasher	( )
		1500	( )	Other 900 sq. ft.		Garbage Grdr.	(✓)
		Other _____				Other _____	

NOTIFY HEALTH DEPARTMENT AT LEAST EIGHT HOURS BEFORE TANK IS TO BE INSPECTED.

Final Inspection 5-24-1971 Approved (✓) Disapproved ( )

Remarks _____

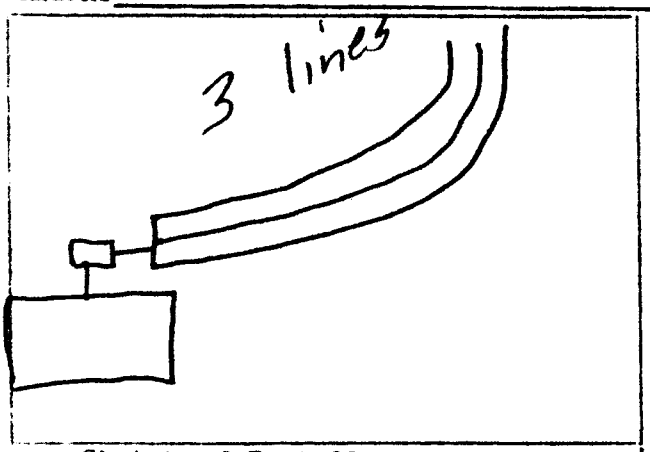

Sketch of Installation

Cross S. Hall

Sanitarian