IREDELL COUNTY HEALTH DEPARTMENT

Statesville Phone TR 3-7271 Mooresville Phone NO 3-1271

PERMIT TO INSTALL SEPTIC TANK

Permit NO. 195 Permit Date JUNE 12 1970

Owner HOPE Bros Builders Inc. Address STATESVILLE, N.C.

Installed By Adam's Septic Tank Service Address TAYLORSVILLE, N.C.


Location of Property HIGHWAY 21 NORTH. LEFT on Road ± 1922 HOUSE on RIGHT. EAST CORNER OF ROAD ± 1955

Tank		Capacity		Length of Lines		Fixtures	
Block	( )	1000	(✓)	225'	( )	No. of Baths	(1)
Precast	(✓)	1250	( )	250'	( )	Dishwasher	( )
		1500	( )	Other 300' 36'		Garbage Grdr.	( )
		Other				Other	

NOTIFY HEALTH DEPARTMENT AT LEAST EIGHT HOURS BEFORE TANK IS TO BE INSPECTED.

Final Inspection JUNE 12 1970 Approved (✓) Disapproved ( )

Remarks IREDELL WATER Corp. FHA

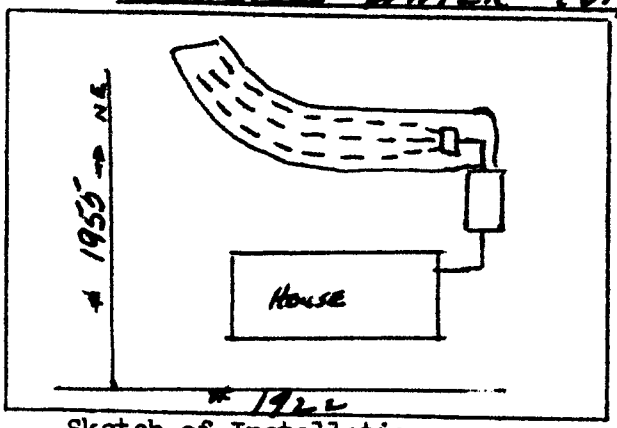

Sketch of Installation

Sanitarian