IREDELL COUNTY HEALTH DEPARTMENT

Statesville Phone TR 3-7271 — Mooresville Phone NO 3-1271

PERMIT TO INSTALL SEPTIC TANK

Permit No. 63 — Permit Date _____ 19__

Owner Alfred Levan — Address _____

Installed By Herman Gibson — Address _____


Location of Property Iredell Heights - Job # 7 of Levans. Victoria Drive. House with carport entrance from back of house.

Tank		Capacity		Length of Lines		Fixtures	
Block	( )	1000	( )	225'	( )	No. of Baths	1½
Precast	(✓)	1250	( )	250'	( )	Dishwasher	( )
		1500	( )	Other 900 sq'		Garbage Grdr.	( )
		Other _____				Other _____	

NOTIFY HEALTH DEPARTMENT AT LEAST EIGHT HOURS BEFORE TANK IS TO BE INSPECTED.

Final Inspection 5-12-52 — Approved (✓) Disapproved ( )

Remarks Iredell Water Corp

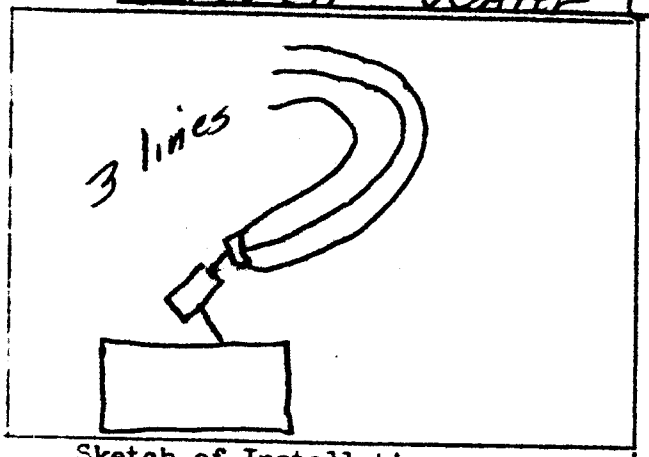

Sketch of Installation

Sanitarian

+00175