IREDELL COUNTY HEALTH DEPARTMENT

STATESVILLE 704-878-5305 (A1) MOORESVILLE 704-664-5281

IMPROVEMENT PERMIT / AUTHORIZATION TO CONSTRUCT / OPERATION PERMIT / EXISTING SYSTEM INSPECTION

PERMIT# 124509 PIN# 4746-36-1896 DATE 11-3-04

OWNER OR CONTRACTOR PINNACLE HOUSING GROUP LTD. PHONE: Business (704) 895-4622 Home

ADDRESS 16315-F NORTHCROSS DRIVE HUNTERSVILLE NC 28078

LOCATION US 21 N TL SHUMAKER TL NIXON TL VICTORIA 1ST LOT ON LT CORNER LOT

SUBDIVISION APPLE HEIGHTS BLOCK / SECTION III LOT 125-128 AREA 0.46 SITE CLASS. PS DESIGN FLOW 360 L.T.A.R. 0.3 gpd/ft²

Septic Tank: 1000 Gallons; STB 1012 Date 6-20-04
Pump Tank: Gallons; PT Date
Pump Make: Model Serial No.
Nitrification Field: No Fields 1 Square Feet 1200 Linear Feet 300'
No Lines 4 Trench Width 36" Max Trench Bottom Depth 36" Gravel Depth 12"

☑ New System ☐ Repair System Type: I, II, (III) IV, V, VI
System Description: GRAVITY 25% REDUCTION
Repair System Description: LP PANEL 50% RED
Maintenance Agreement Required: ☐ Yes ☑ No

☑ House/Mod. Home No. Bedrooms 3
☐ Mobile Home No. Bathrooms 2
☐ Business No. Employees
☐ Other
☐ Slab ☑ Crawl Space ☐ Basement w/plumbing ☐ Basement wo/plumbing


Water Supply: ☐ Individual ☑ Public ☐ Community

Comments:/Conditions: (1) INSTALL ON CONTOUR (2) MAINTAIN SETBACKS (3) GRADE OFF BERMS (4) MUST REMOVE RED MAPLE TREES IN SEPTIC AREA

Comments:/Conditions: SEPTIC TANK WITH MARKER INSTALLED USING "ZABEC" FILTER

* 1"=40'

INITIAL SITE SKETCH

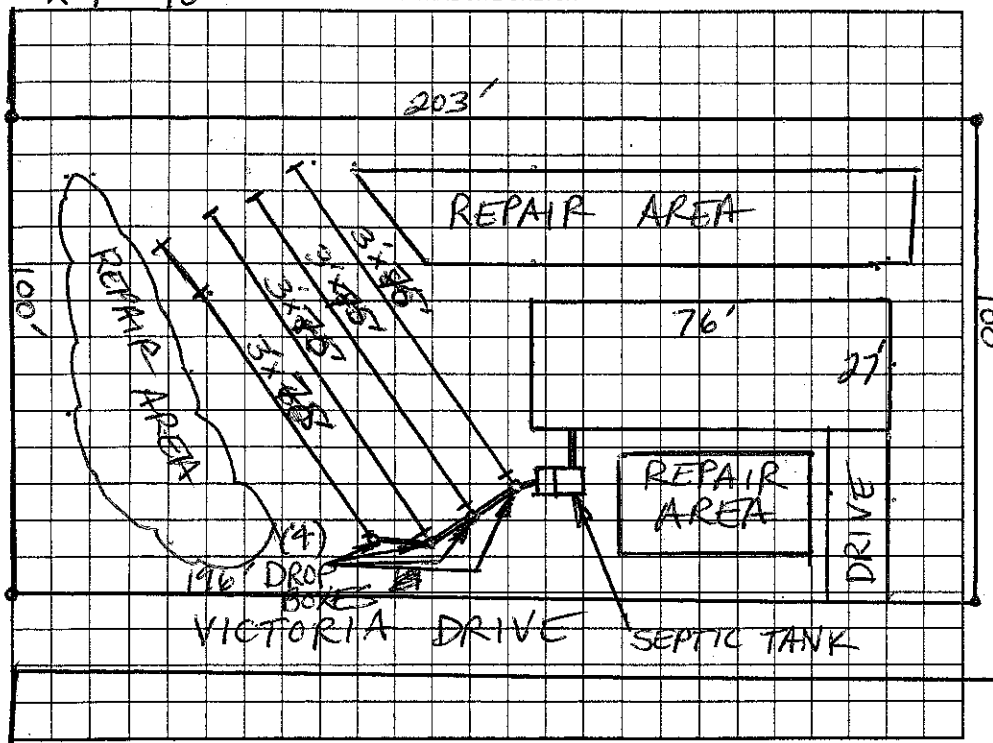

AS BUILT SKETCH

SYSTEM INSTALLED AS SHOWN

Permit can be suspended or revoked if any false information is supplied toward securing the permit/any unauthorized changes are made to the site/any unauthorized changes are made in the installation of the system. Improvement Permit with plat valid without expiration. Improvement Permit with site plan valid for sixty months. Authorization to Construct is valid for a period equal to that of Improvement Permit – not to exceed sixty months.

Signed: Jena Johnston date 11-3-04

Improvement Permit by: [signature] LS date 11-3-04

Authorization to Construct by: [signature] LS date 11-3-04

Installed by: A-1 BACKHOE

Operation Permit by: STEVE HENDRICK date 11-19-04

Existing System Inspection by: date

HEALTH DEPT. COPY: WHITE OWNER COPY (FINAL): YELLOW OWNER COPY (INITIAL): PINK