IREDELL COUNTY HEALTH DEPARTMENT

Statesville Phone TR 3-7271 Mooresville Phone NO 3-1271

PERMIT TO INSTALL SEPTIC TANK

Permit No. _____ Permit Date 8-12 1971

Owner Hope Bros. Bridders Inc Address Statesville, NC.

Installed By Hope Bros. Address Statesville NC

Location of Property Highway 21 N. Turn left on Road # 1922 -


IREDELL HEIGHTS # 492

| Tank | | Capacity | | Length of Lines | | Fixtures | |
|---|---|---|---|---|---|---|---|
| Block | ( ) | 1000 | (✓) | 225' | ( ) | No. of Baths | (1½) |
| Precast | (✓) | 1250 | ( ) | 250' | ( ) | Dishwasher | ( ) |
| | | 1500 | ( ) | Other 300 | | Garbage Grdr. | ( ) |
| | | Other _____ | | 900 sq. ft | | Other _____ | |

NOTIFY HEALTH DEPARTMENT AT LEAST EIGHT HOURS BEFORE TANK IS TO BE INSPECTED.

Final Inspection 8-12 1971 Approved (✓) Disapproved ( )

Remarks IREDELL WATER CORP.

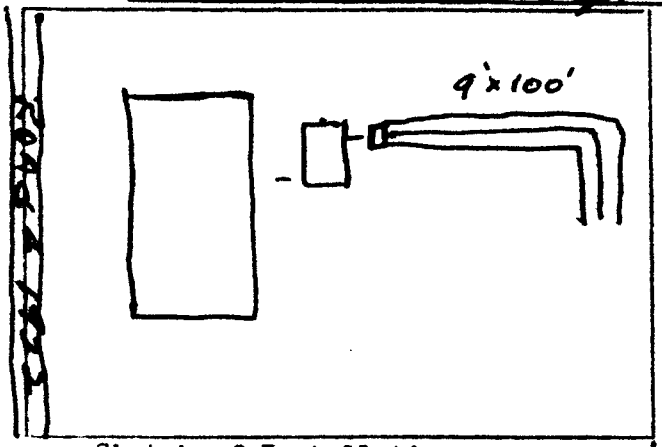


Sketch of Installation

Sanitarian