IREDELL COUNTY HEALTH DEPARTMENT

Statesville Phone TR 3-7271 Mooresville Phone NO 3-1271

PERMIT TO INSTALL SEPTIC TANK

Permit No. 115 Permit Date _____ 19__

Owner Hope Brothers Address Statesville

Installed By Hope Brothers Address "


Location of Property Lot #496 Iredell Heights

Tank		Capacity		Length of Lines		Fixtures	
Block	( )	1000	(✓)	225'	( )	No. of Baths	(1½)
Precast	(✓)	1250	( )	250'	( )	Dishwasher	( )
		1500	( )	Other 900 g'		Garbage Grdr.	( )
		Other _____				Other _____	

NOTIFY HEALTH DEPARTMENT AT LEAST EIGHT HOURS BEFORE TANK IS TO BE INSPECTED.

Final Inspection 8-11-1971 Approved (✓) Disapproved ( )

Remarks Iredell Water Corp

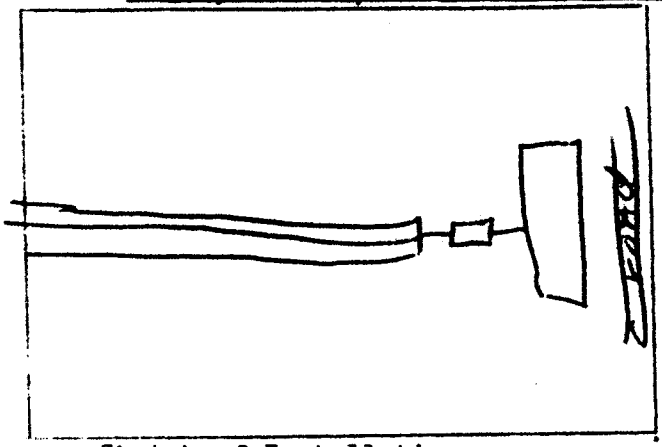

Sketch of Installation

C S Hall

Sanitarian