IREDELL COUNTY HEALTH DEPARTMENT

Statesville Phone TR 3-7271 Mooresville Phone NO 3-1271

PERMIT TO INSTALL SEPTIC TANK

Permit No. 64 Permit Date _____ 19__

Owner Hope Bus Builders Address Statesville N C

Installed By Hope Bus Builders Address Statesville N.C.

Location of Property Iredell Heights. RD.# 1922


Shoemaker Drive Lot # 500

Tank		Capacity		Length of Lines		Fixtures	
Block	( )	1000	(✓)	225'	( )	No. of Baths	(1½)
Precast	(✓)	1250	( )	250'	( )	Dishwasher	( )
		1500	( )	Other 700 Sq ft		Garbage Grdr.	( )
		Other _____				Other _____	

NOTIFY HEALTH DEPARTMENT AT LEAST EIGHT HOURS BEFORE TANK IS TO BE INSPECTED.

Final Inspection 1-20 1972 Approved (✓) Disapproved ( )

Remarks Water from Iredell Water Corp

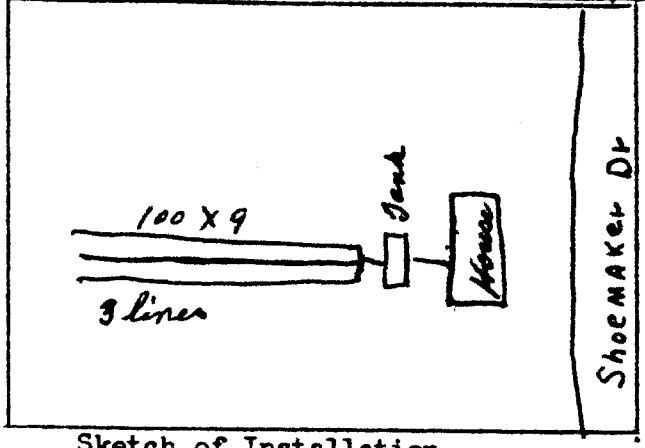

Sketch of Installation

E. G. Stevenson

Sanitarian