IREDELL COUNTY HEALTH DEPARTMENT

Statesville Phone TR 3-7271 Mooresville Phone NO 3-1271

PERMIT TO INSTALL SEPTIC TANK

Permit No. 112 Permit Date 2-28 1972

Owner Hope Bros Builders Inc. Address Statesville, N.C

Installed By Hope Bros. Address Statesville, N.C

Location of Property Iredell Heights -

Shoemaker Rd.


Lot # 504

Tank		Capacity		Length of Lines		Fixtures	
Block	( )	1000	(✓)	225'	( )	No. of Baths	(2)
Precast	(✓)	1250	( )	250'	( )	Dishwasher	( )
		1500	( )	Other 300 · 900 sq ft		Garbage Grdr.	( )
		Other				Other	

NOTIFY HEALTH DEPARTMENT AT LEAST EIGHT HOURS BEFORE TANK IS TO BE INSPECTED.

Final Inspection 2-28 1972 Approved (✓) Disapproved ( )

Remarks Iredell Water Corp.

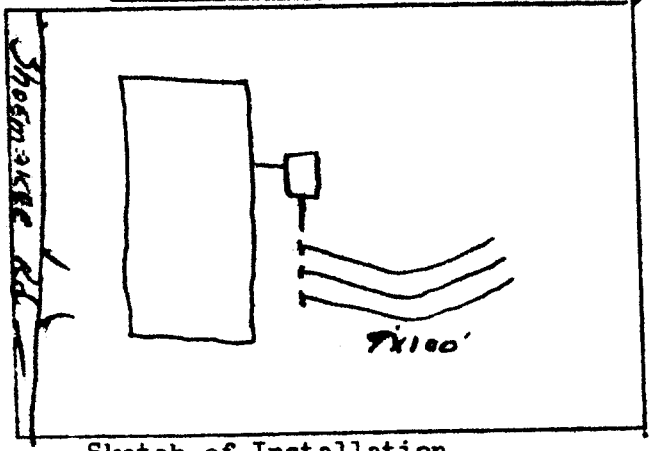

Sketch of Installation

Sanitarian