IREDELL COUNTY HEALTH DEPARTMENT

Statesville Phone TR 3-7271 Mooresville Phone NO 3-1271

PERMIT TO INSTALL SEPTIC TANK

Permit No. 124 (3L OR) Permit Date 3-6 1972

Owner Hope Bros Bldrs Inc. Address STATESVILLE, NC

Installed By Hope Bros Address STATESVILLE, N.C

Location of Property IREDELL HEIGHTS -

SHOEMAKER DRIVE # 1922


LOT # 508

Tank		Capacity		Length of Lines		Fixtures	
Block	( )	1000	(✓)	225'	( )	No. of Baths	(1½)
Precast	(✓)	1250	( )	250'	( )	Dishwasher	( )
		1500	( )	Other 300		Garbage Grdr.	( )
		Other		900 sq. ft.		Other	

NOTIFY HEALTH DEPARTMENT AT LEAST EIGHT HOURS BEFORE TANK IS TO BE INSPECTED.

Final Inspection 3-6 1972 Approved (✓) Disapproved ( )

Remarks WATER SUPPLY - IREDELL WATER CORP.

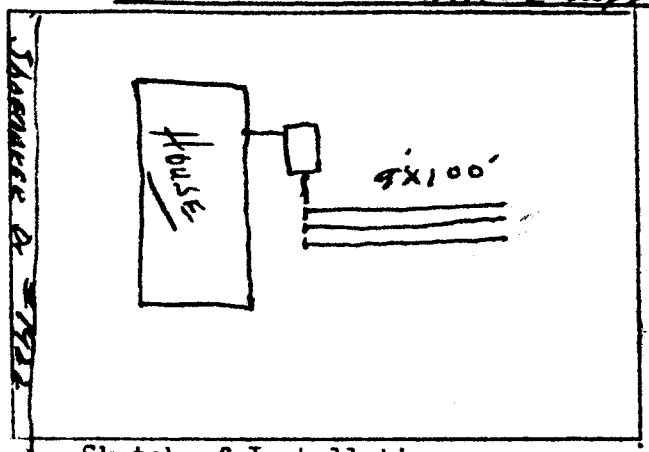

Sketch of Installation

Glenn Todd Jr.

Sanitarian